


**LAKEVIEW  
MEDICAL  
ARTS  
CENTER**

**Floor 01**

**Suite 74**  
AS-BUILT

**1,119 SF**  
AVAILABLE

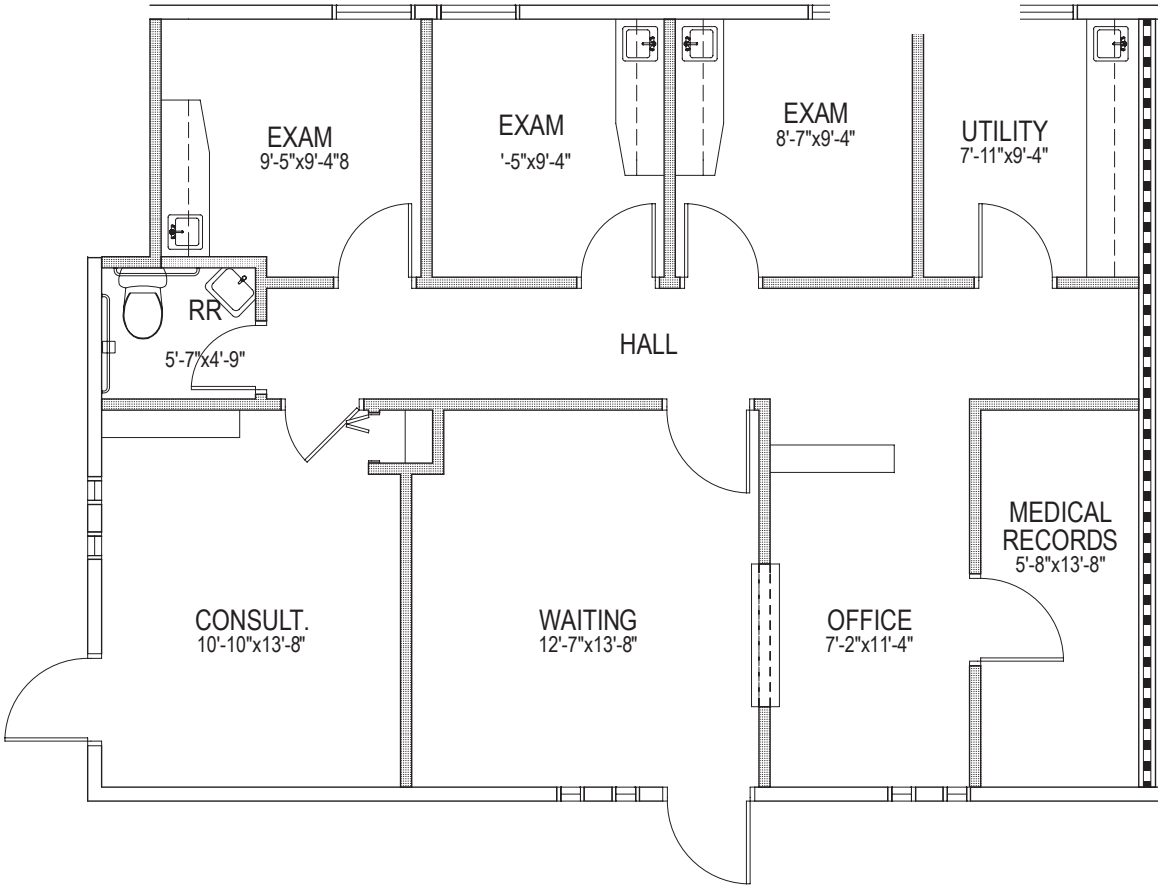

**RACHAEL THOMPSON**  
Senior Vice President  
602.513.5122  
rachael.thompson@kidder.com

**PERRY GABUZZI, CCIM**  
Senior Vice President  
602.513.5116  
perry.gabuzzi@kidder.com