

# GRANITE VALLEY MEDICAL OFFICE


## Floor 2

Suite 201

AS-BUILT

7,613 SF

AVAILABLE

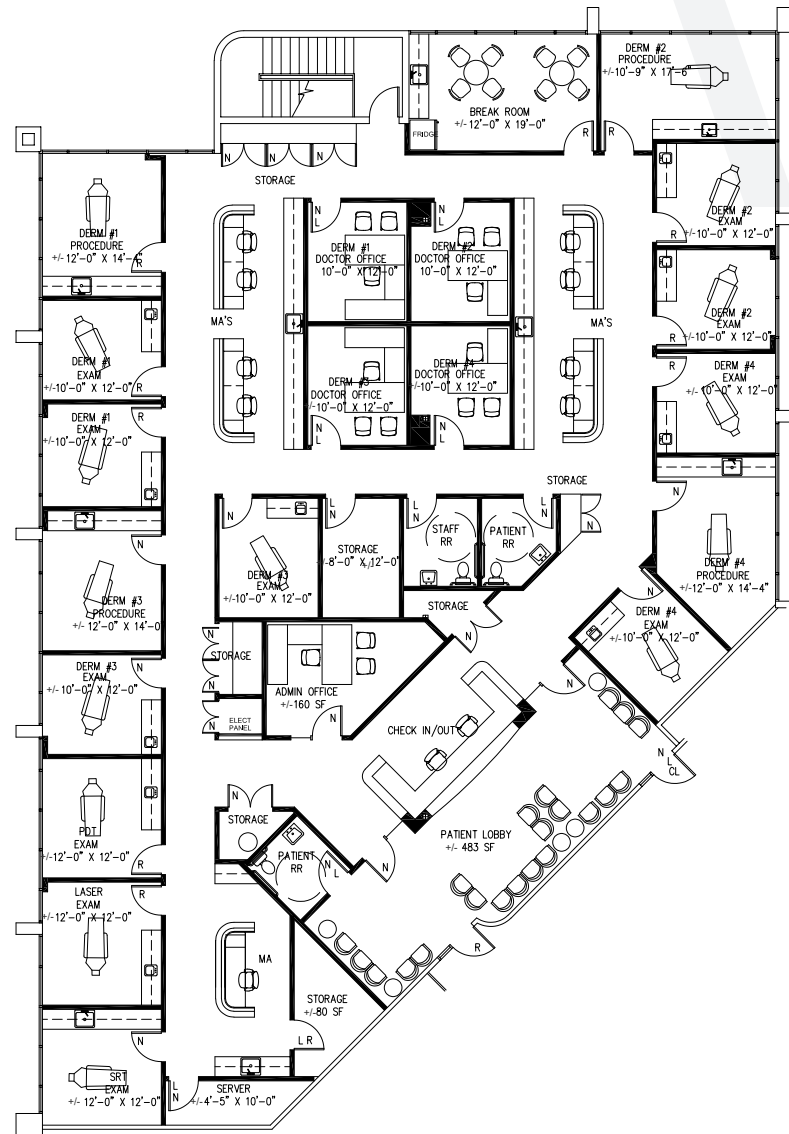

**RACHAEL THOMPSON**  
Senior Vice President  
602.513.5122  
rachael.thompson@kidder.com

**PERRY GABUZZI, CCIM**  
Senior Vice President  
602.513.5116  
perry.gabuzzi@kidder.com