


SUITE 600
AVAILABLE
3075.10 RSF

SUITE 605

SUITE 610
AVAILABLE
1141.92 RSF

SUITE 650
AVAILABLE
3166.76 RSF

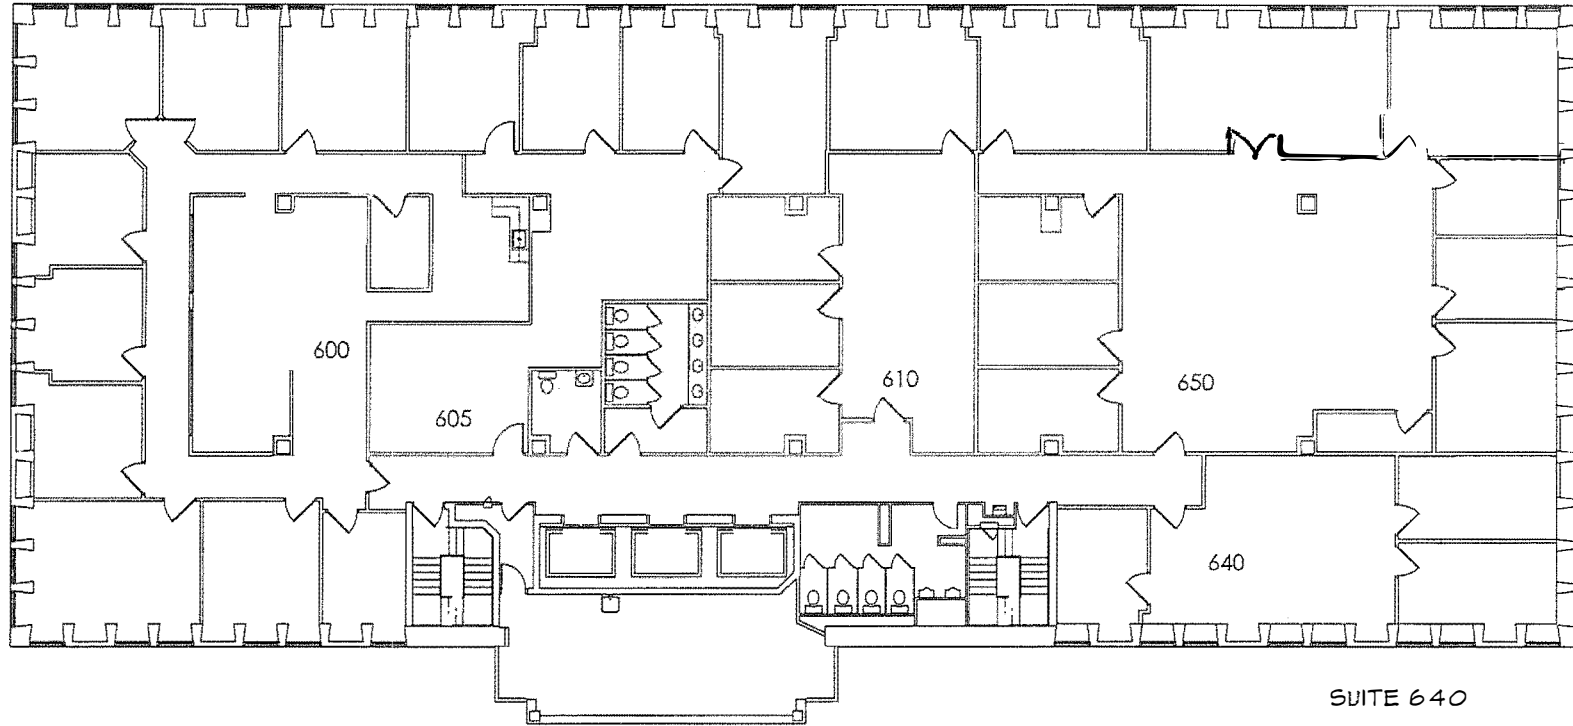

SUITE 640

1061.91 RSF

A FLOOR PLAN 
SCALE: NTS NORTH



KKT ARCHITECTS, INC.
2200 SOUTH UTICA PLACE, SUITE 200
TULSA, OKLAHOMA 74114
[P] 918.744.4270 \ [F] 918.744.7849
WWW.KKTARCHITECTS.COM
C O F A #534 6/30/19

6TH FLOOR PLAN

SOUTHLAND
TOWER
6TH FLOOR



10.25.2019

AS-BUILT
PLAN

AS.6