
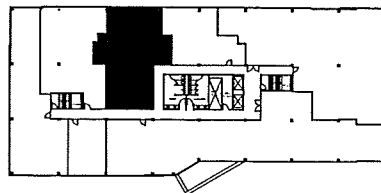


GRAYMARK OFFICE BUILDING

16801 Addison Road, Addison, Texas

SUITE 345
2,056 RSF

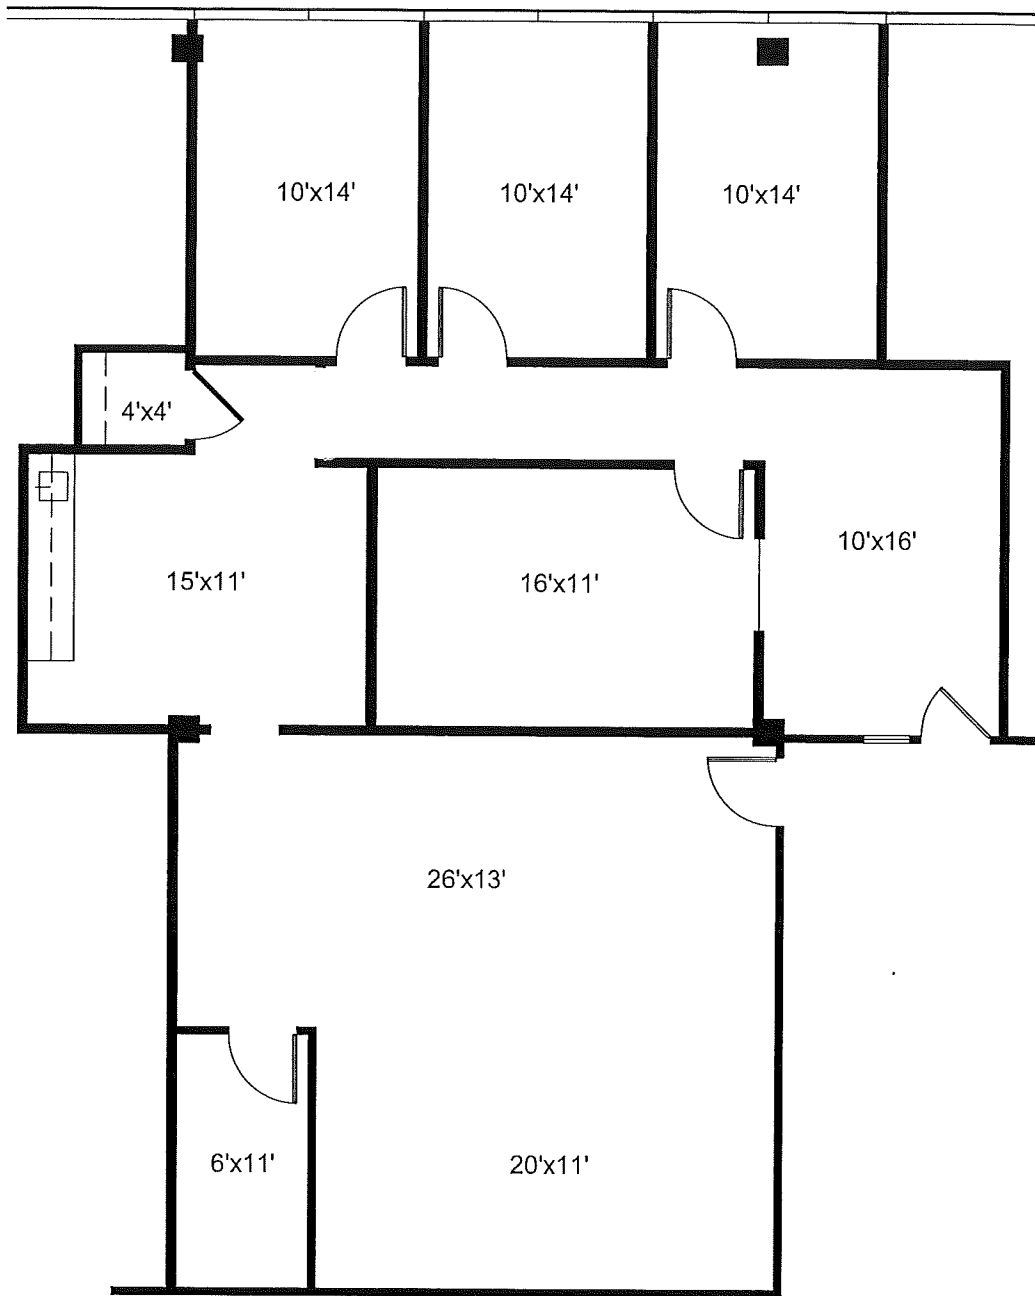

3RD FLOOR

Scale: 1/8"=1'-0"

All dimensions and square footages are approximate.

March 4, 2026