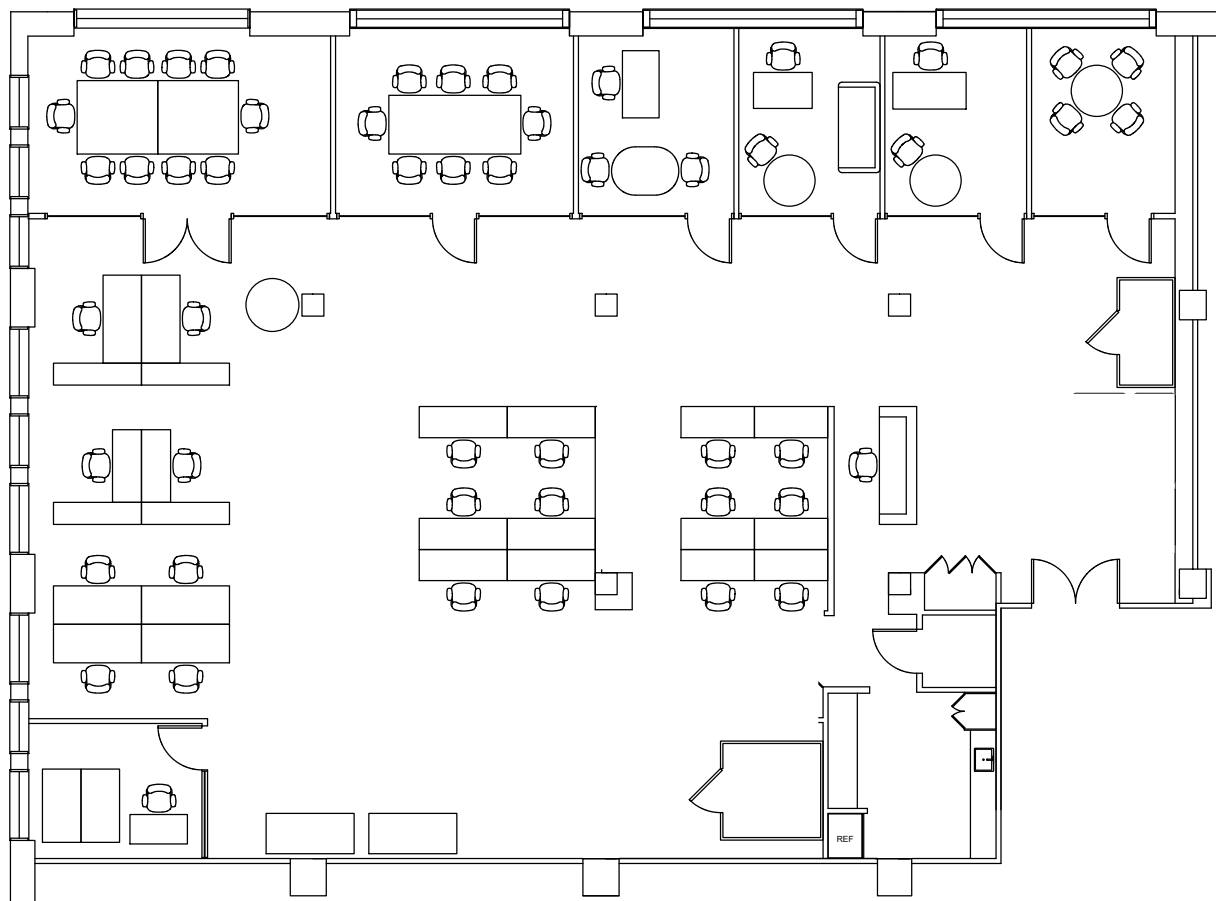


KEY PLAN: NOT TO SCALE