
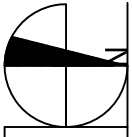


879 North Plaza Drive

Apache Junction . Arizona
Suite 101B - 1,064 SF

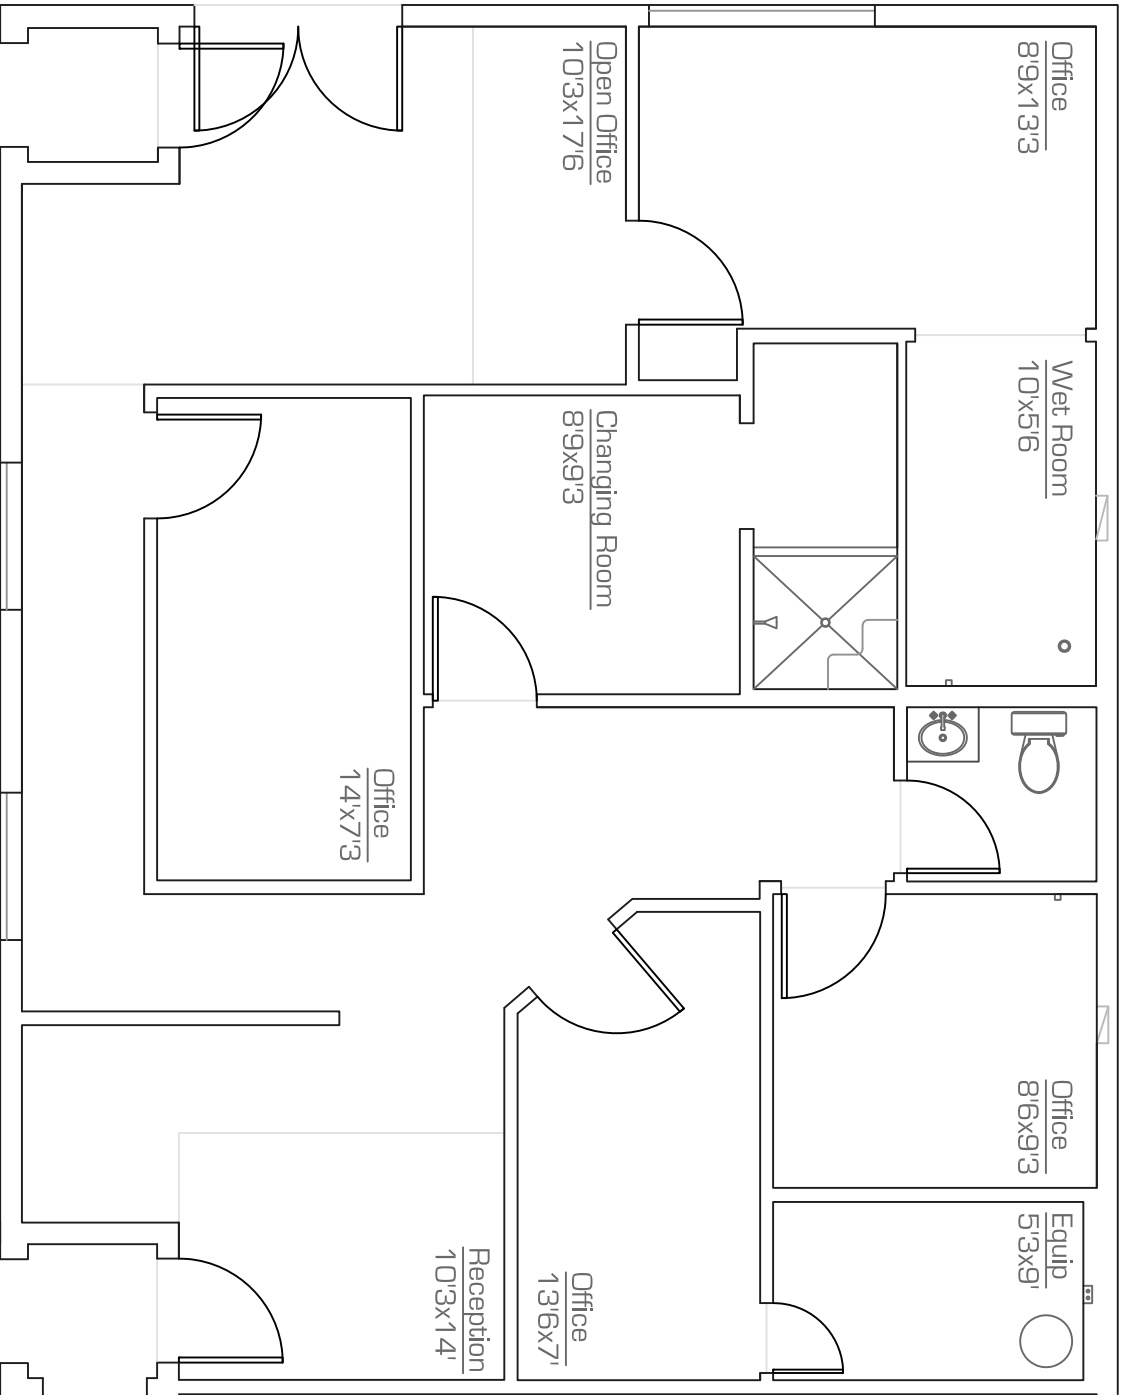

as-built

scale: nts

8.June.2017

* All dimensions are approximate at ± 3"

* All information is of general nature

precision DIMENSIONS

as-built & design
602. 790. 6412

