


SUITE 240-250 10,402 SF

280 SHUMAN BLVD | NAPERVILLE, IL

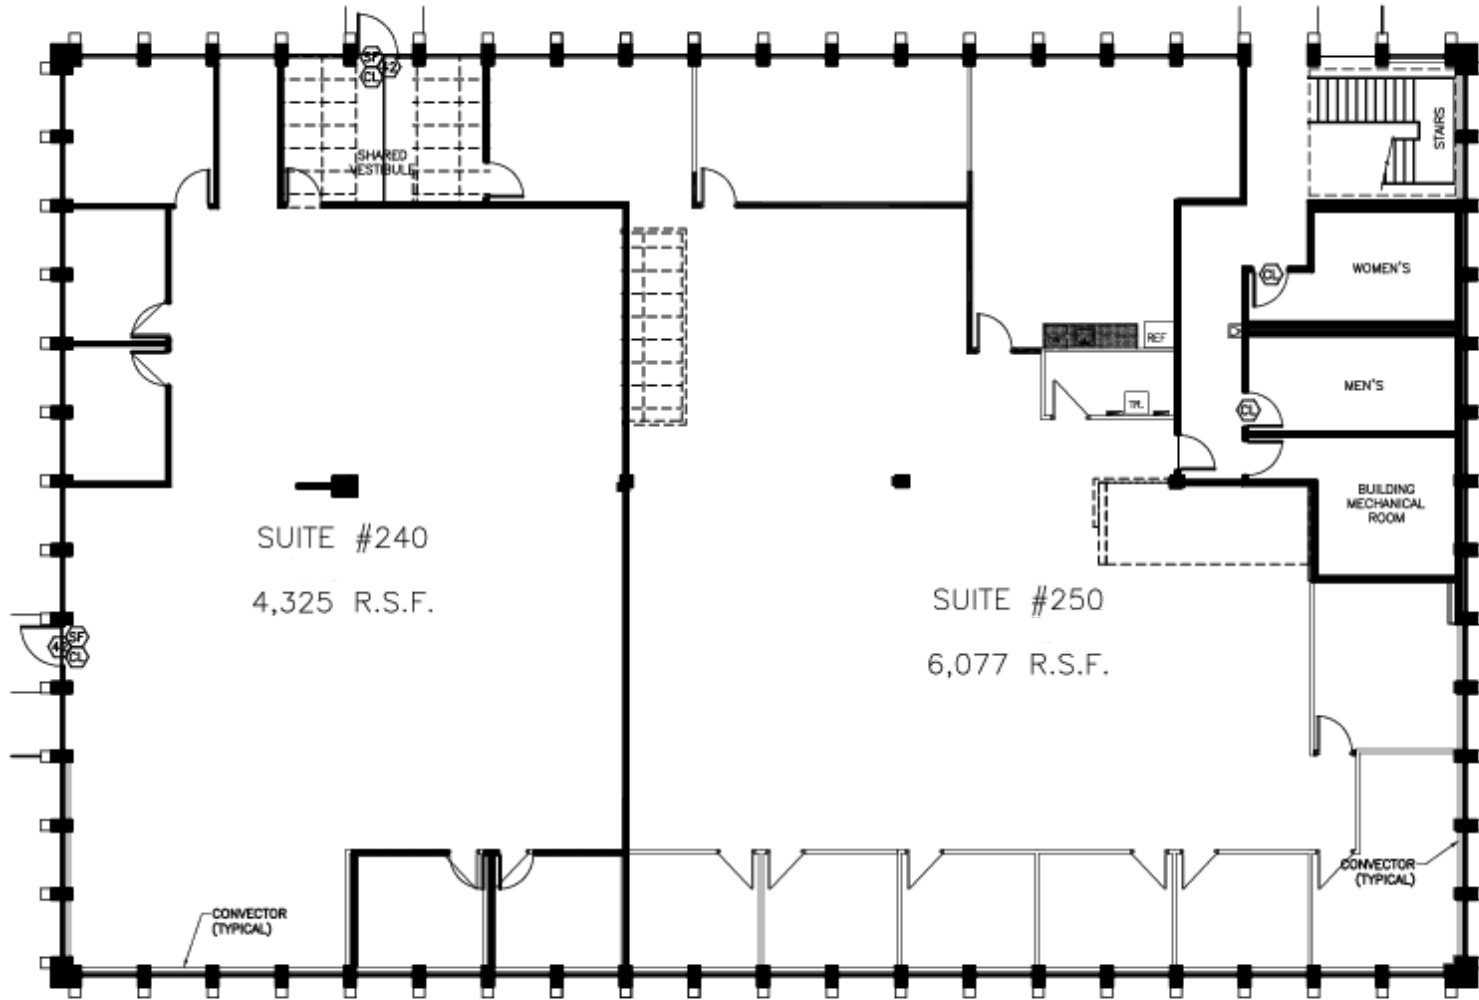

RYAN MOEN
630.480.6346
RMoen@VersaRES.com

JOHN MILLNER
630.480.6342
JMillner@VersaRES.com

1 MID AMERICA PLAZA, 3RD FLOOR
OAKBROOK TERRACE, IL 60181
630.480.6413

VERSA
REAL ESTATE SERVICES