






LASALLE PLAZA

Minneapolis, Minnesota

SUITE 1775 - SUITE AS-BUILT PLAN (1,501 RSF)

1/8" = 1'-0"

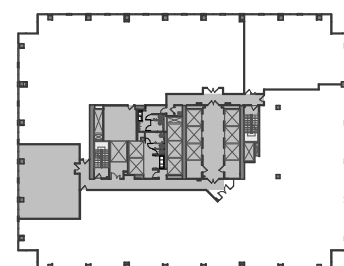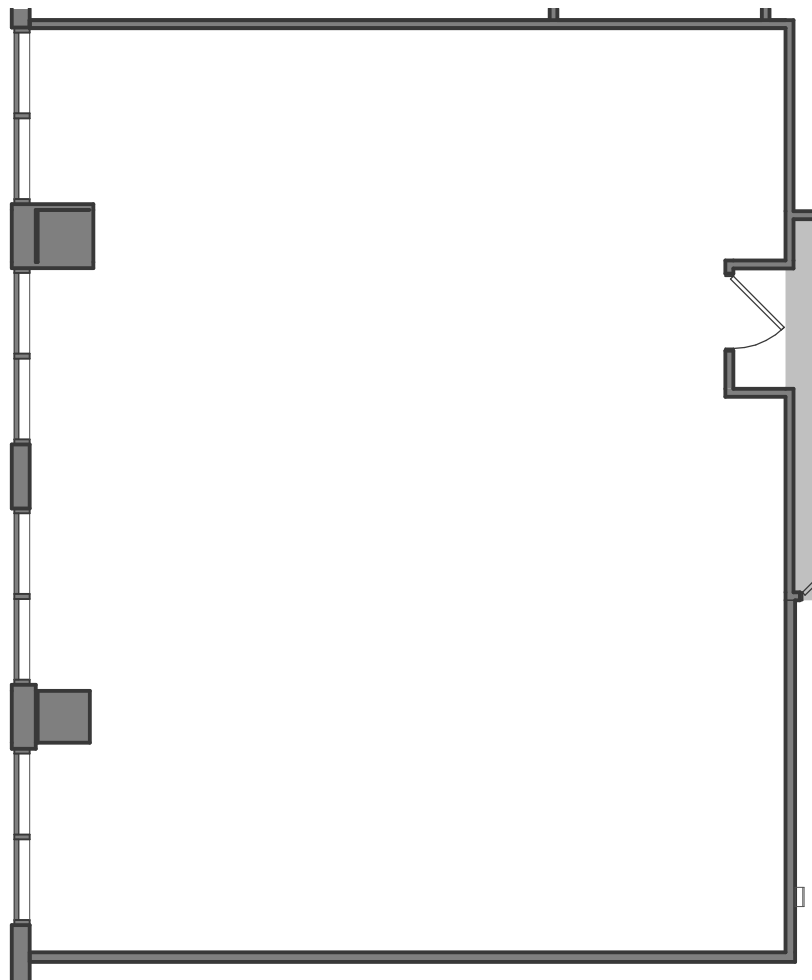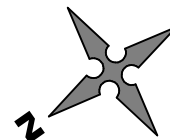

For Information, Contact:

Brent Jacobson: 612-355-2609

Ben Krsnak: 612-355-2608

Julie Yeazle: 612-817-6315



HEMPEL
REAL ESTATE

NELSON

Issue Date: 08/15/2023

FLOOR 17