

# THUNDERBIRD MEDICAL PLAZA III


## Floor 01

### Suite 100

AS-BUILT

### 4,301 SF

AVAILABLE

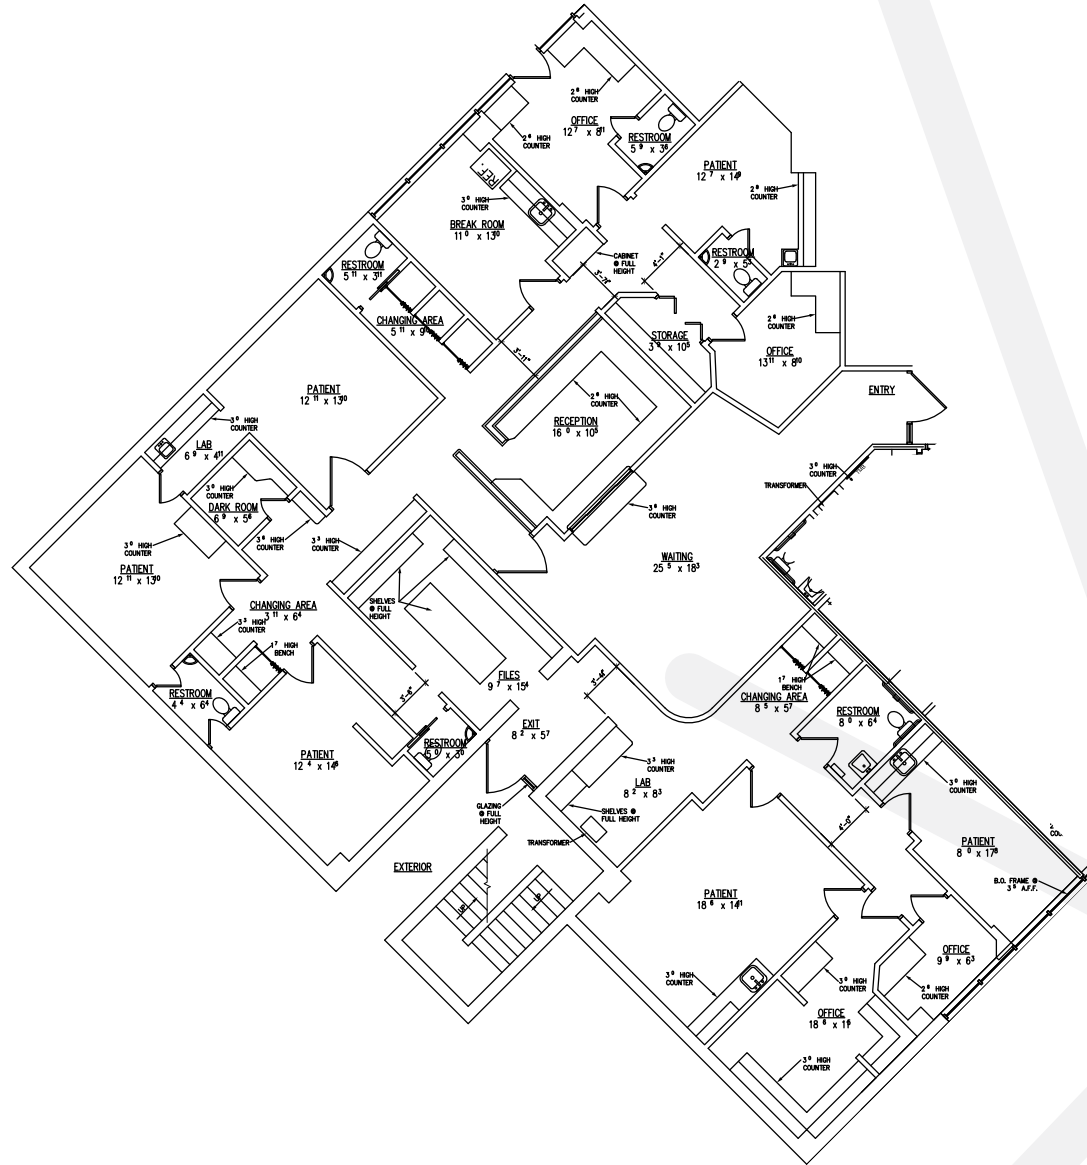

**RACHAEL THOMPSON**  
 Senior Vice President  
 602.513.5122  
 rachael.thompson@kidder.com

**PERRY GABUZZI, CCIM**  
 Executive Vice President  
 602.513.5116  
 perry.gabuzzi@kidder.com



View Portfolio