


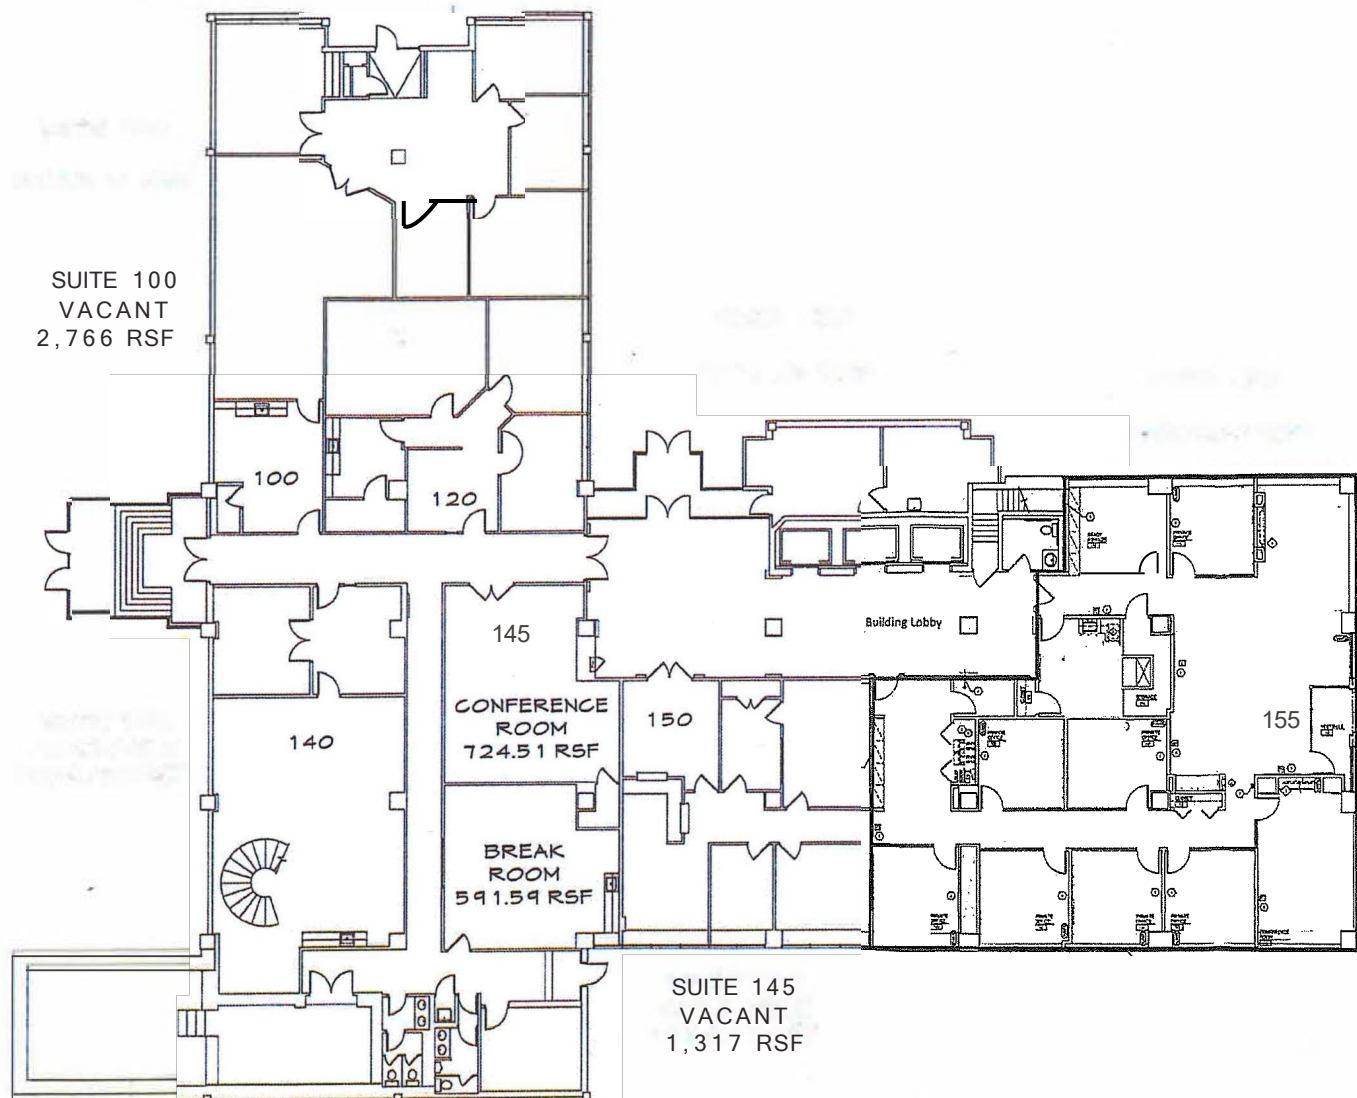

A FLOOR PLAN t)

SCALE: N.T.S.

NORTH


KKT

DESIGN \ INTERIORS \ ENGINEERING

KKT ARCHITECTS, INC.
2200 SOUTH UTICA PLACE, SUITE 200
TULSA, OKLAHOMA 74114
P: 919.744.270 \ F: 919.744.709
WWW.KKTARCHITECTS.COM
C of A #534 6/30/11

1ST FLOOR PLAN

SOUTHLAND
TOWER
1ST FLOOR

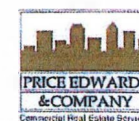

10.25.2019

AS-BUILT
PLAN

AS.1