


8966 Benson Ave., Ste. B
Montclair, CA.
1,440 SF

Neighboring Suite A

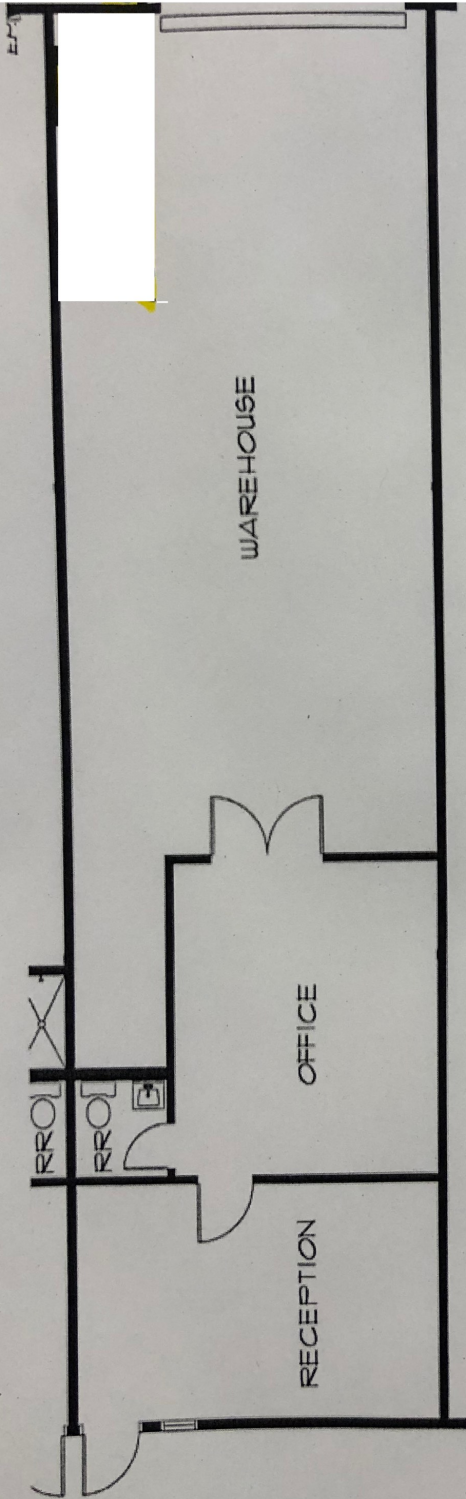


WAREHOUSE

RECEPTION

OFFICE

Neighboring Suite C

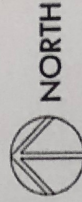

NORTH

BENSON COMMERCE CENTER


N.T.S

AS BUILT PLAN - SUITE B

8966 BENSON AVE

MONTCLAIR, CA 91763

FEB 11, 2011

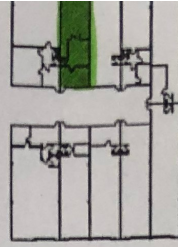

SISSONDESIGN^{pro}