
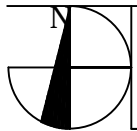


973 North Colorado Street
Gilbert . Arizona
Building - 52,780 SF

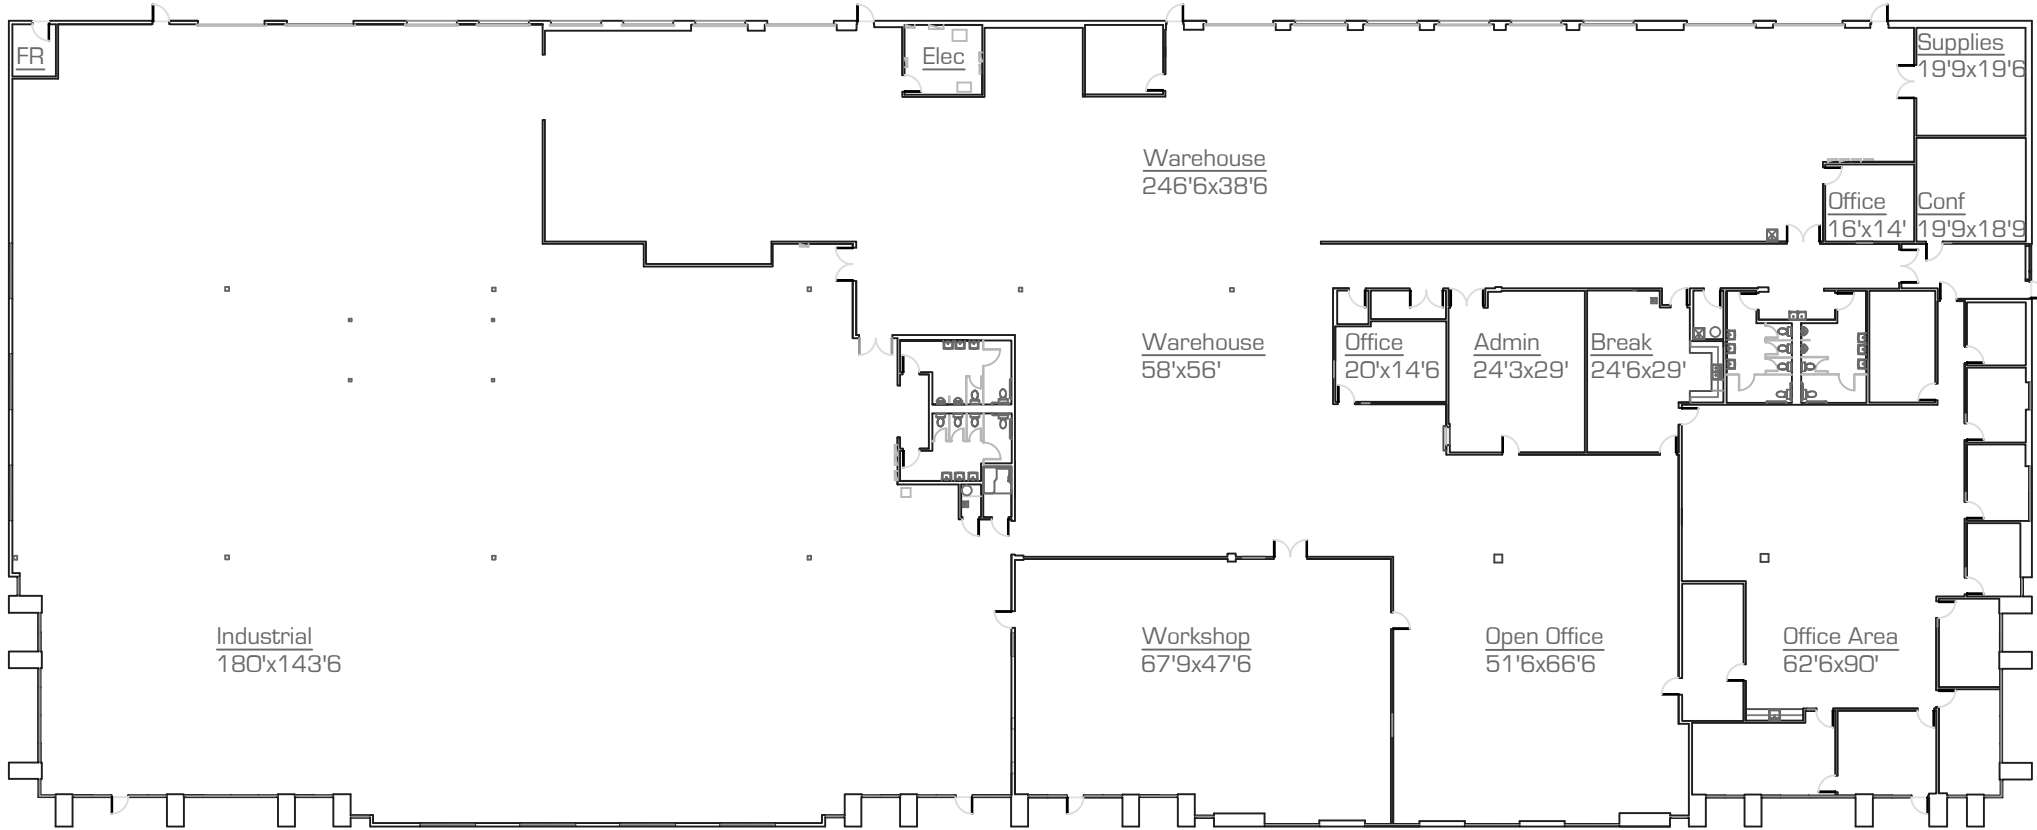

As-Built - floor plan

scale: nts

10.March.2026

*All dimensions are approximate at $\pm 3''$

*All information is of general nature

precisionDIMENSIONS

as-built & survey
602.790.6412

