


# Oakbrook Center Mall Professional Office Building

120 Oak Brook Center Mall  
Oak Brook, Illinois 60523

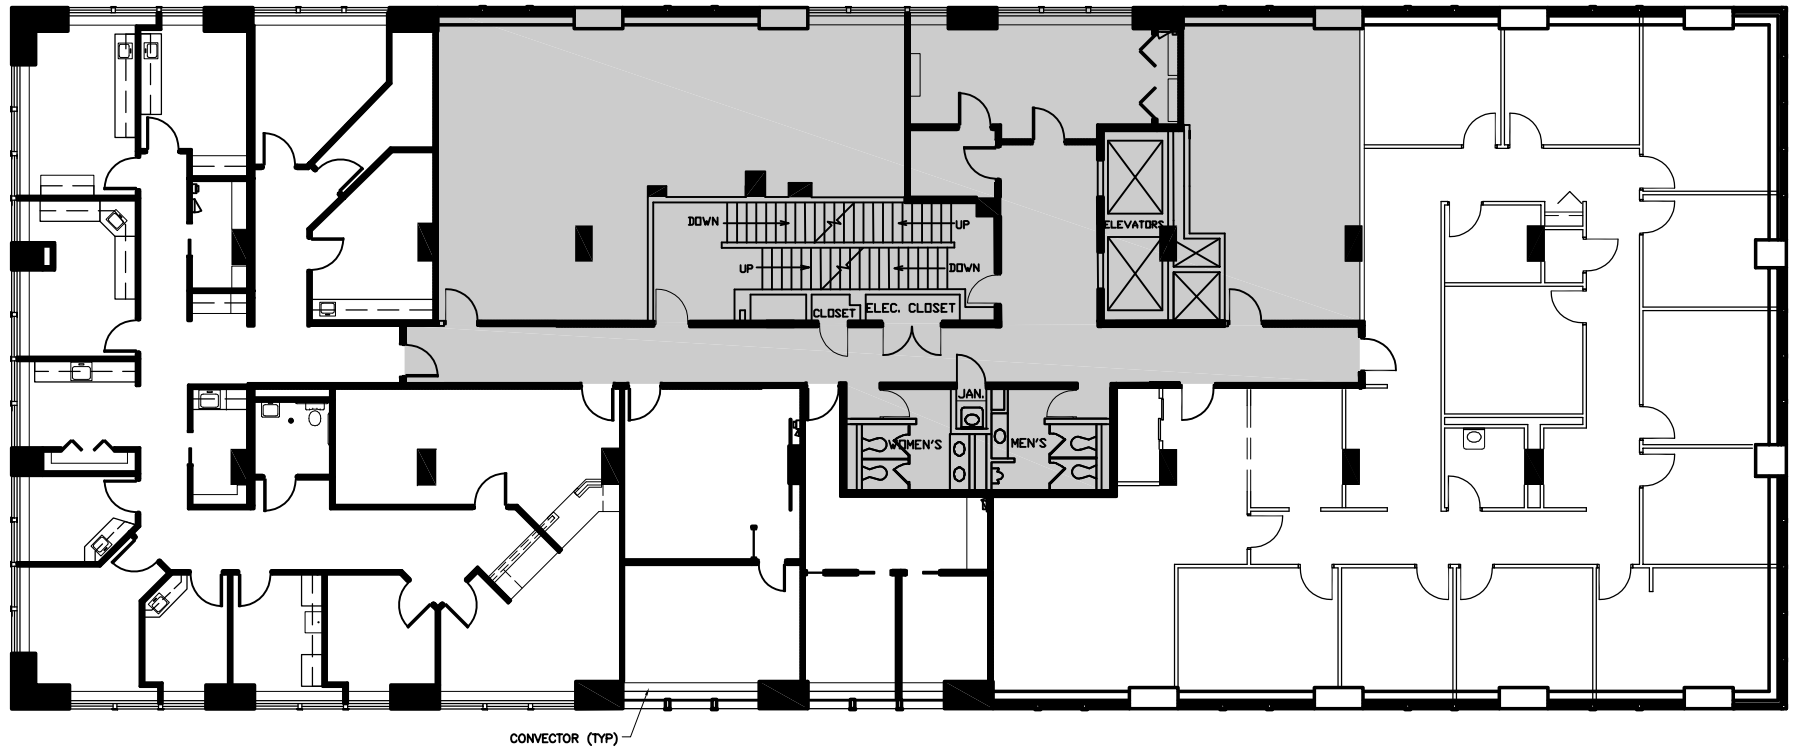

## Suites #208, 214, 216 and 220 - As-Built Conditions

7,276 Useable Square Feet

Scale:

N.T.S.

August 13, 2018

