


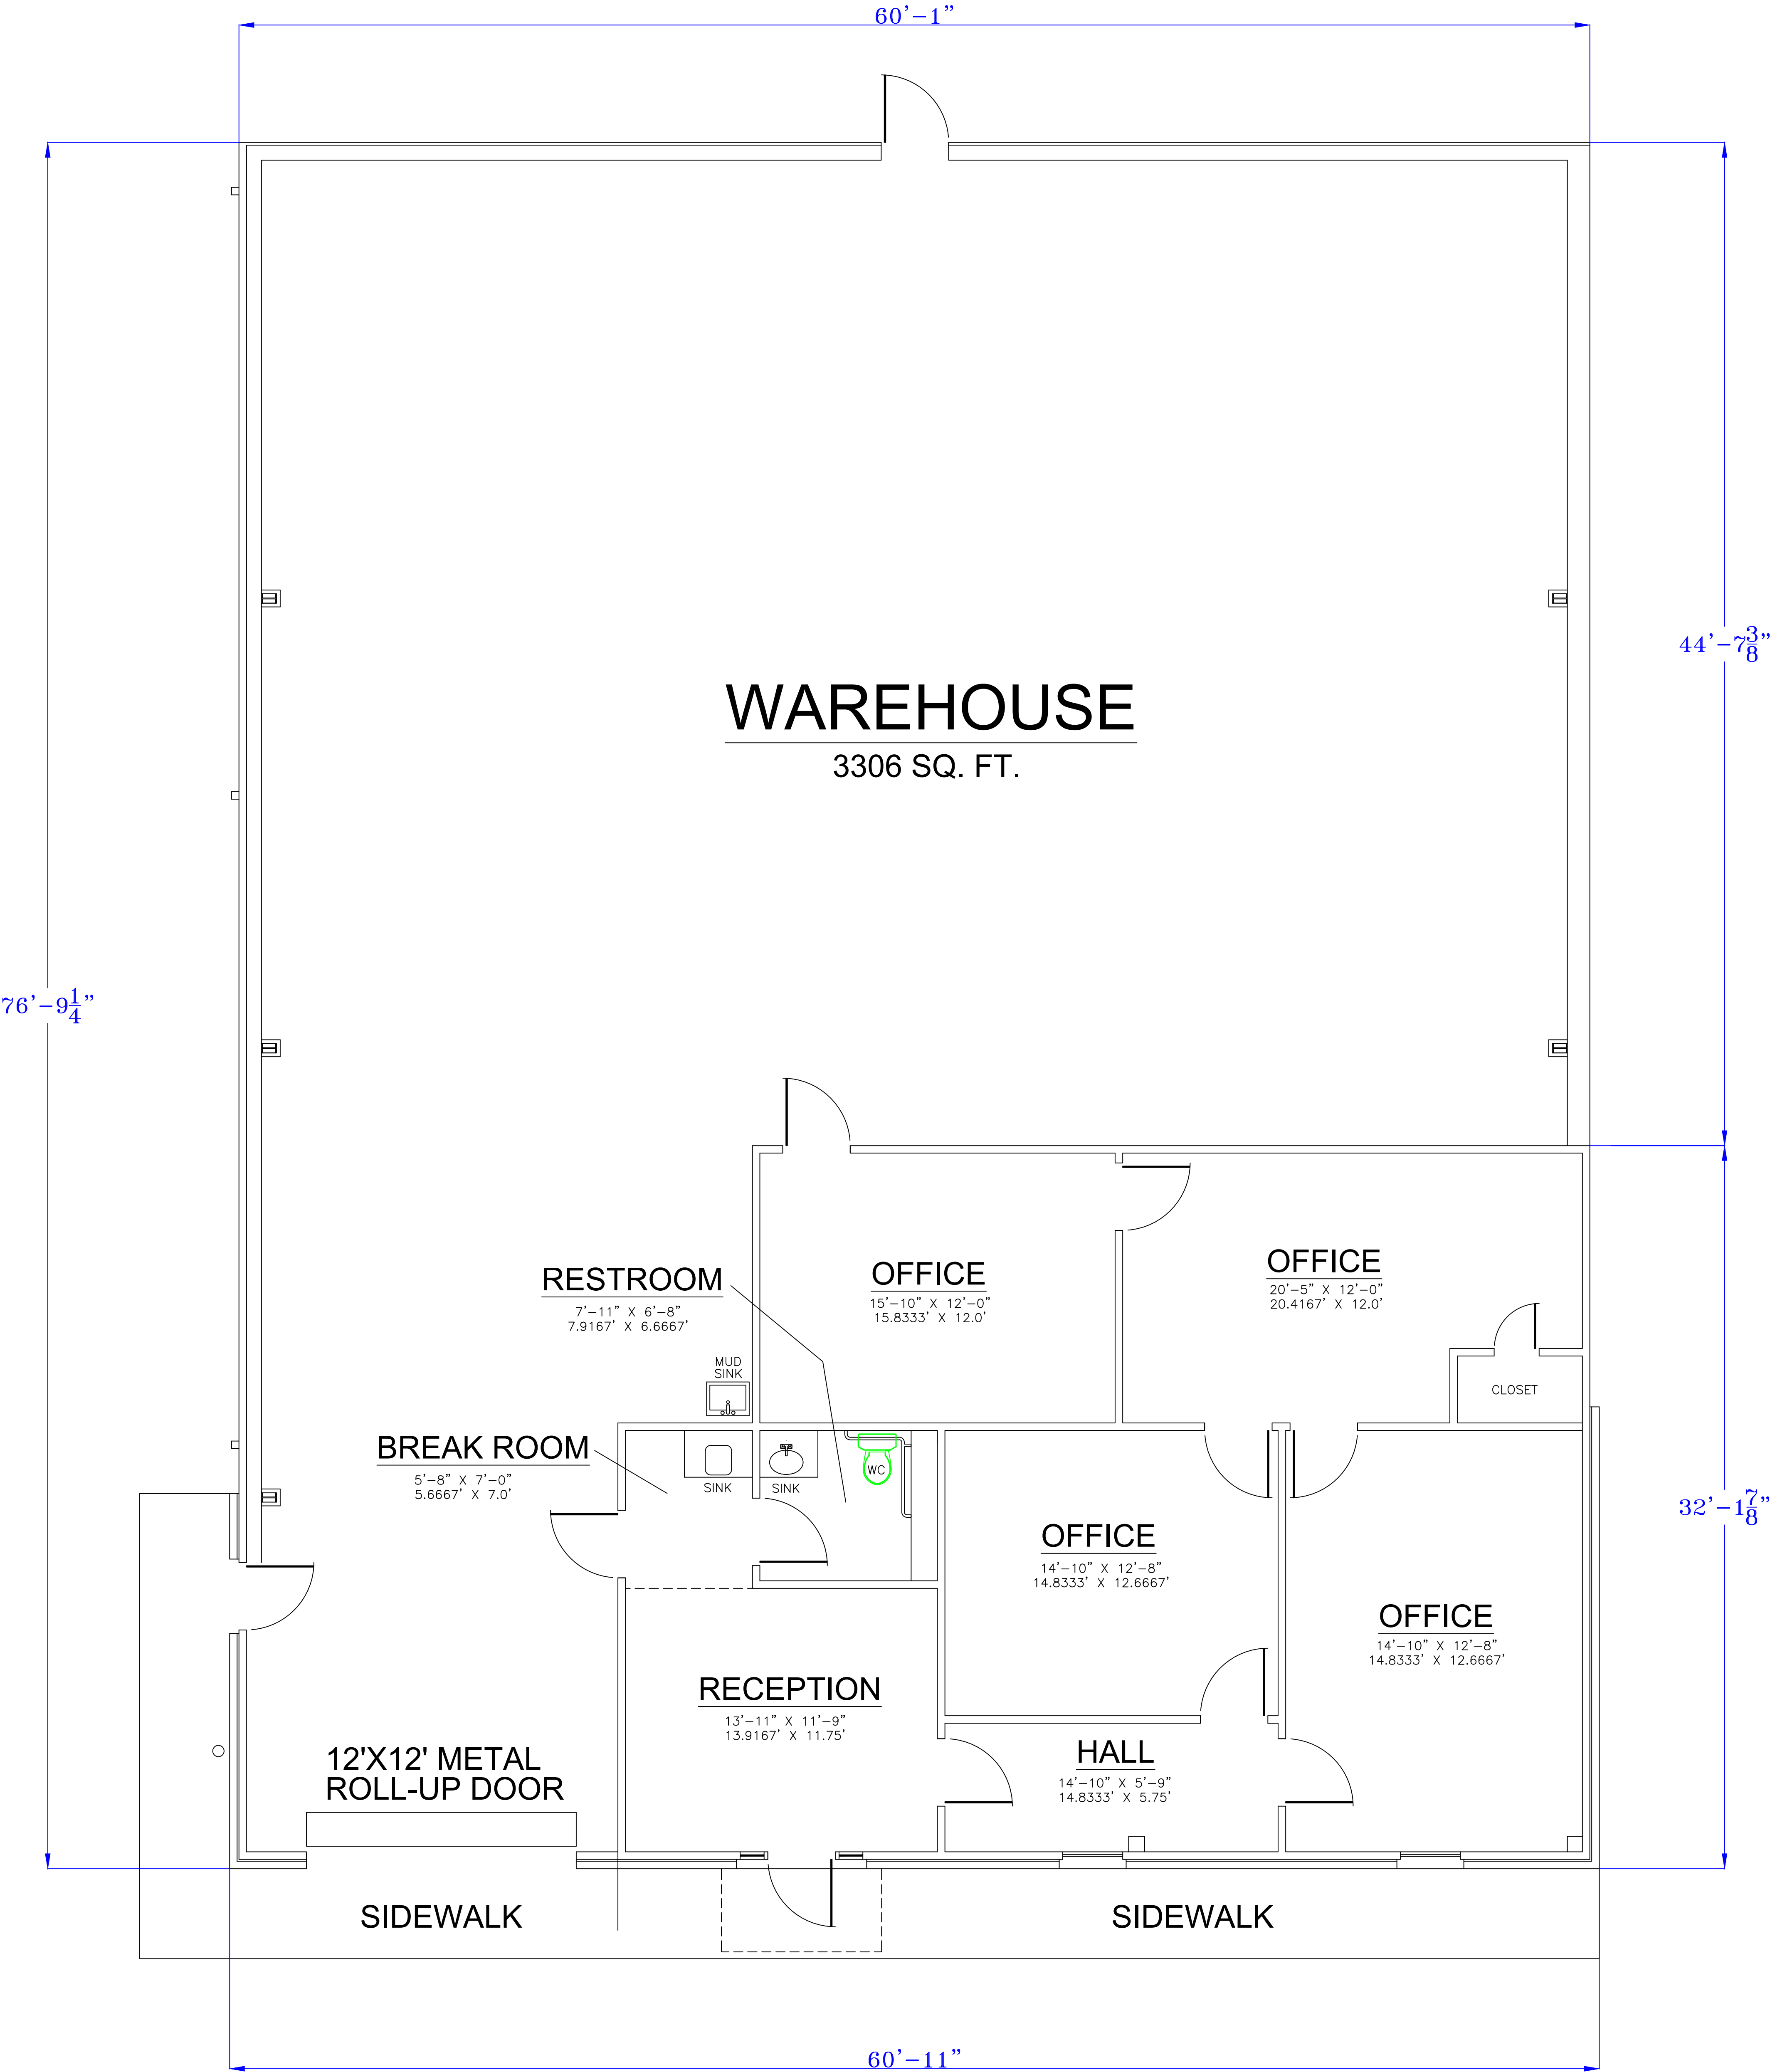

FLOOR PLAN

2708 S. RUBY AVE. GONZALES, LA.
AS-BUILT

SQUARE FOOTAGE	
OFFICE AREA	3306 SQ.FT.
WAREHOUSE AREA	1305 SQ.FT.
TOTAL	4611 SQ.FT.