

ESTRELLA  
MEDICAL  
CENTER

9305 W THOMAS RD | PHOENIX, AZ 85037


# Floor 05

Suite 585

AS-BUILT

1,574 SF

AVAILABLE

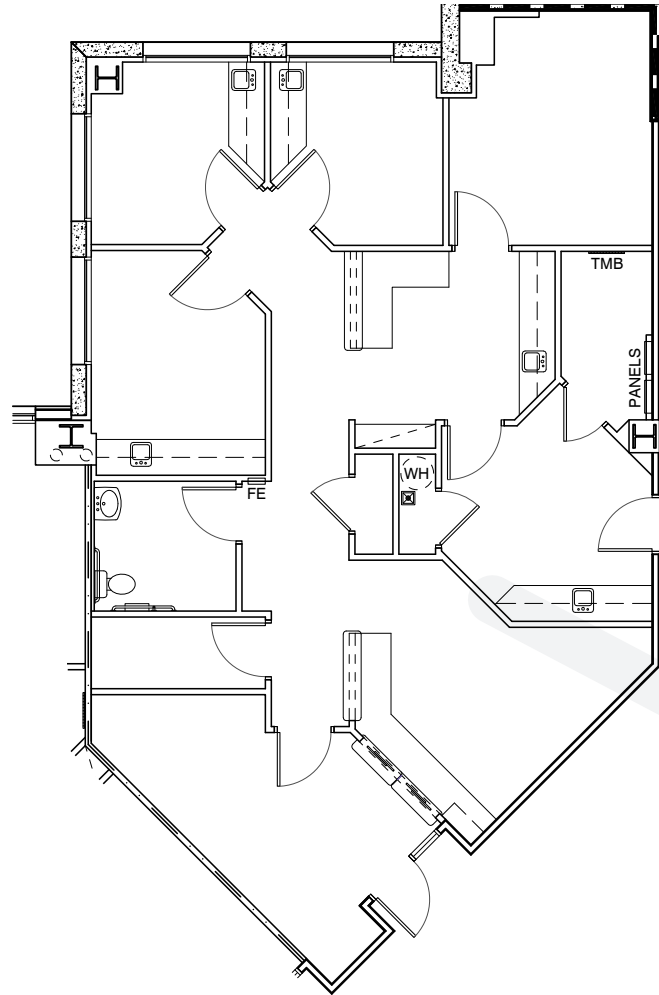

**RACHAEL THOMPSON**  
Senior Vice President  
602.513.5122  
rachael.thompson@kidder.com

**PERRY GABUZZI, CCIM**  
Senior Vice President  
602.513.5116  
perry.gabuzzi@kidder.com