

**BOSWELL  
WEST MEDICAL  
OFFICE  
BUILDING**

10503 W THUNDERBIRD BLVD | SUN CITY, AZ 85351


# Floor 02

Suite 220

AS-BUILT

5,318 SF

AVAILABLE

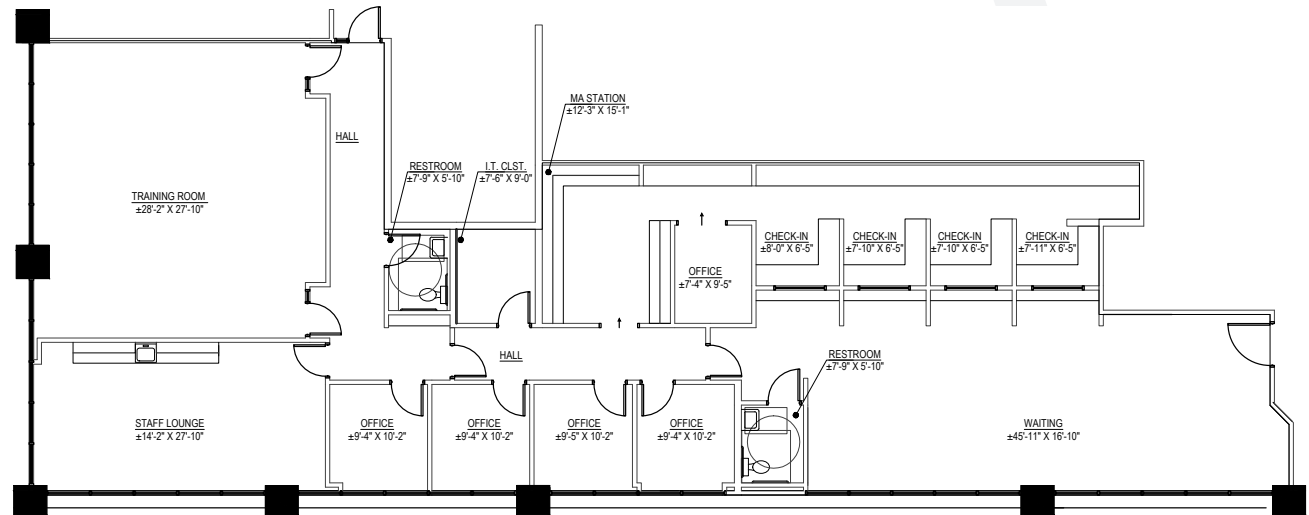

**RACHAEL THOMPSON**  
Senior Vice President  
602.513.5122  
rachael.thompson@kidder.com

**PERRY GABUZZI, CCIM**  
Senior Vice President  
602.513.5116  
perry.gabuzzi@kidder.com