
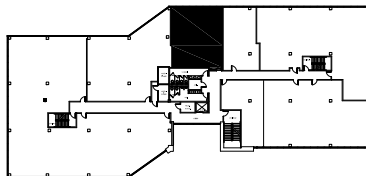


# TWIN CENTRAL OFFICE BUILDING

1401 N. Central, Richardson, Texas

SUITE 350  
1,326 RSF

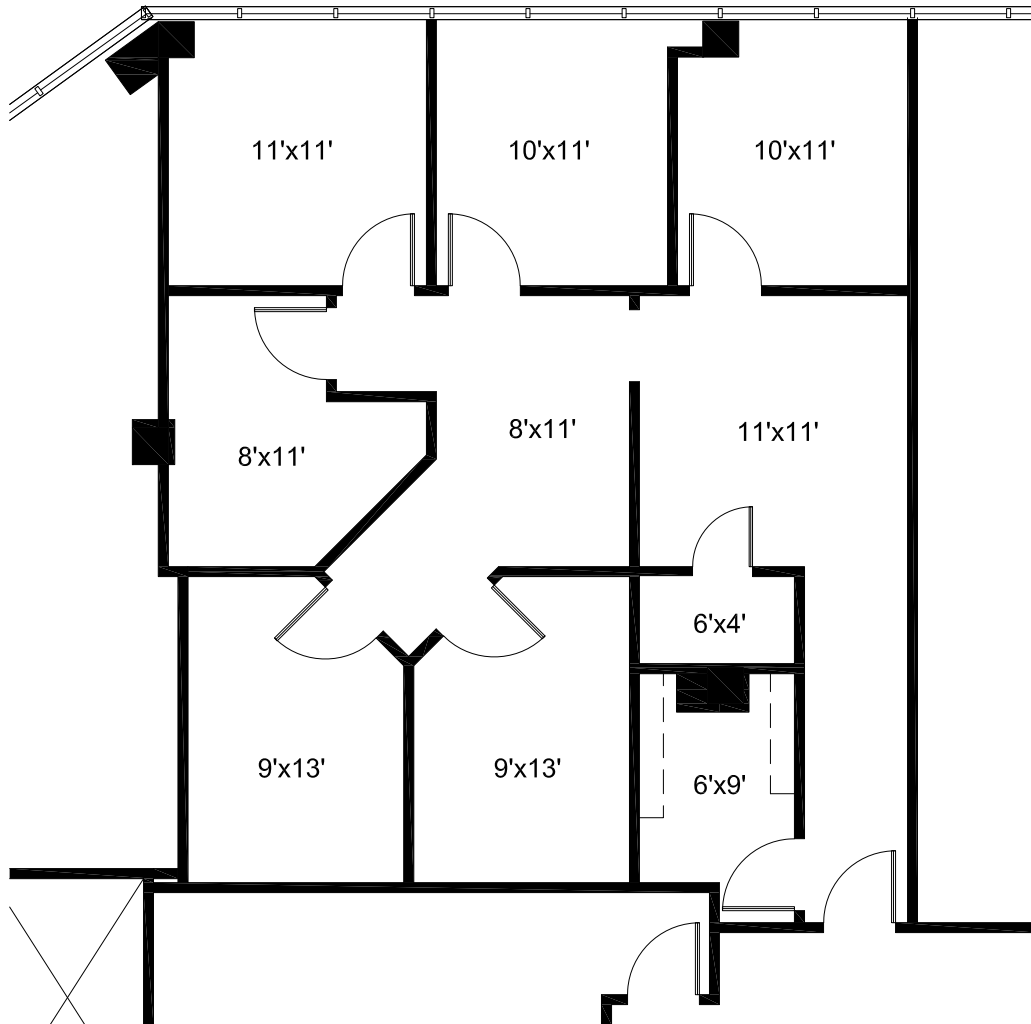

3RD FLOOR

Scale: 1/8"=1'-0"

All dimensions and square footages are approximate.

March 18, 2026