


One Oakbrook Terrace

22nd Street & Butterfield Road
Oakbrook Terrace, Illinois 60181

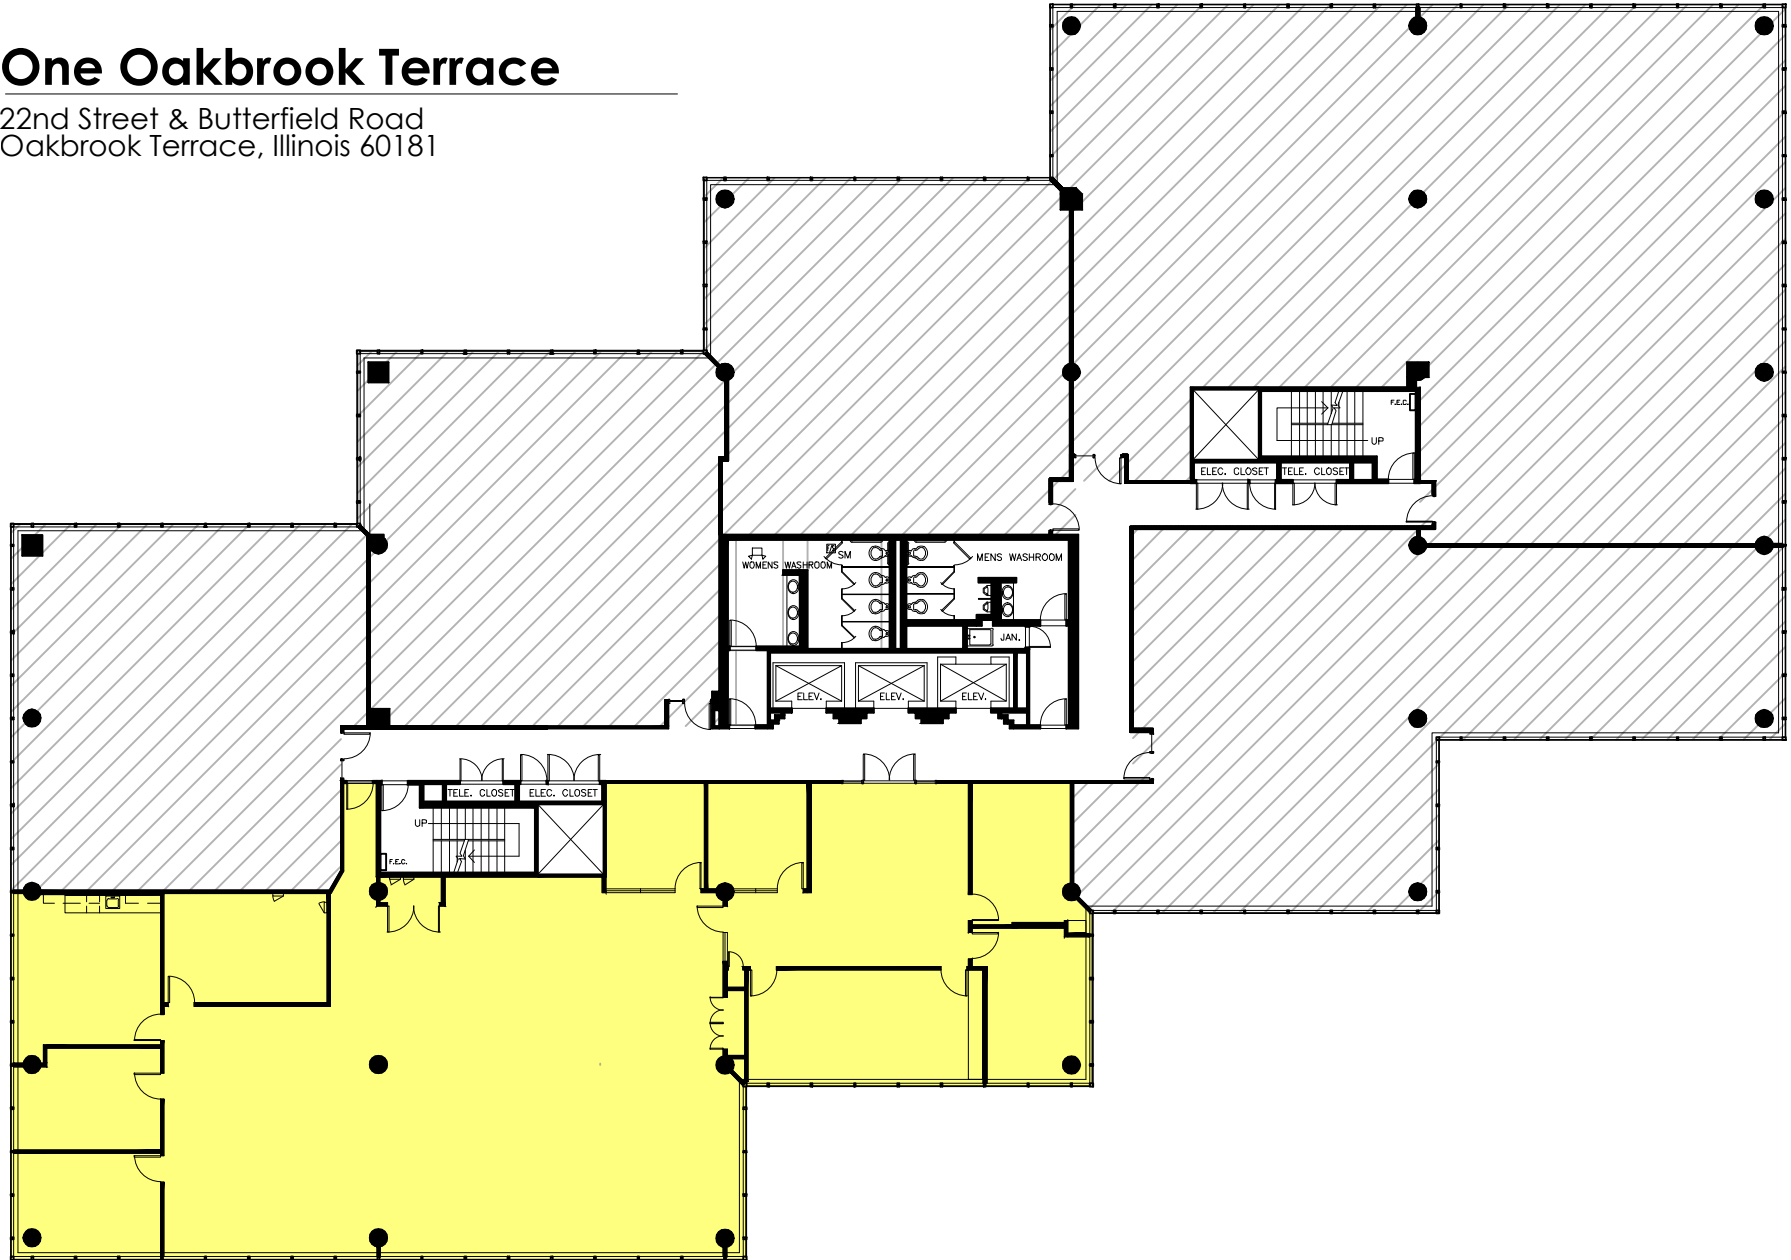

Suite #200 - As-Built Conditions

6,141 Rentable Square Feet

Scale:

N.T.S.

NAIHiffman
Commercial Real Estate Services, Worldwide.

