


# SUITE 402: 1,745 RSF

SPACE AVAILABLE

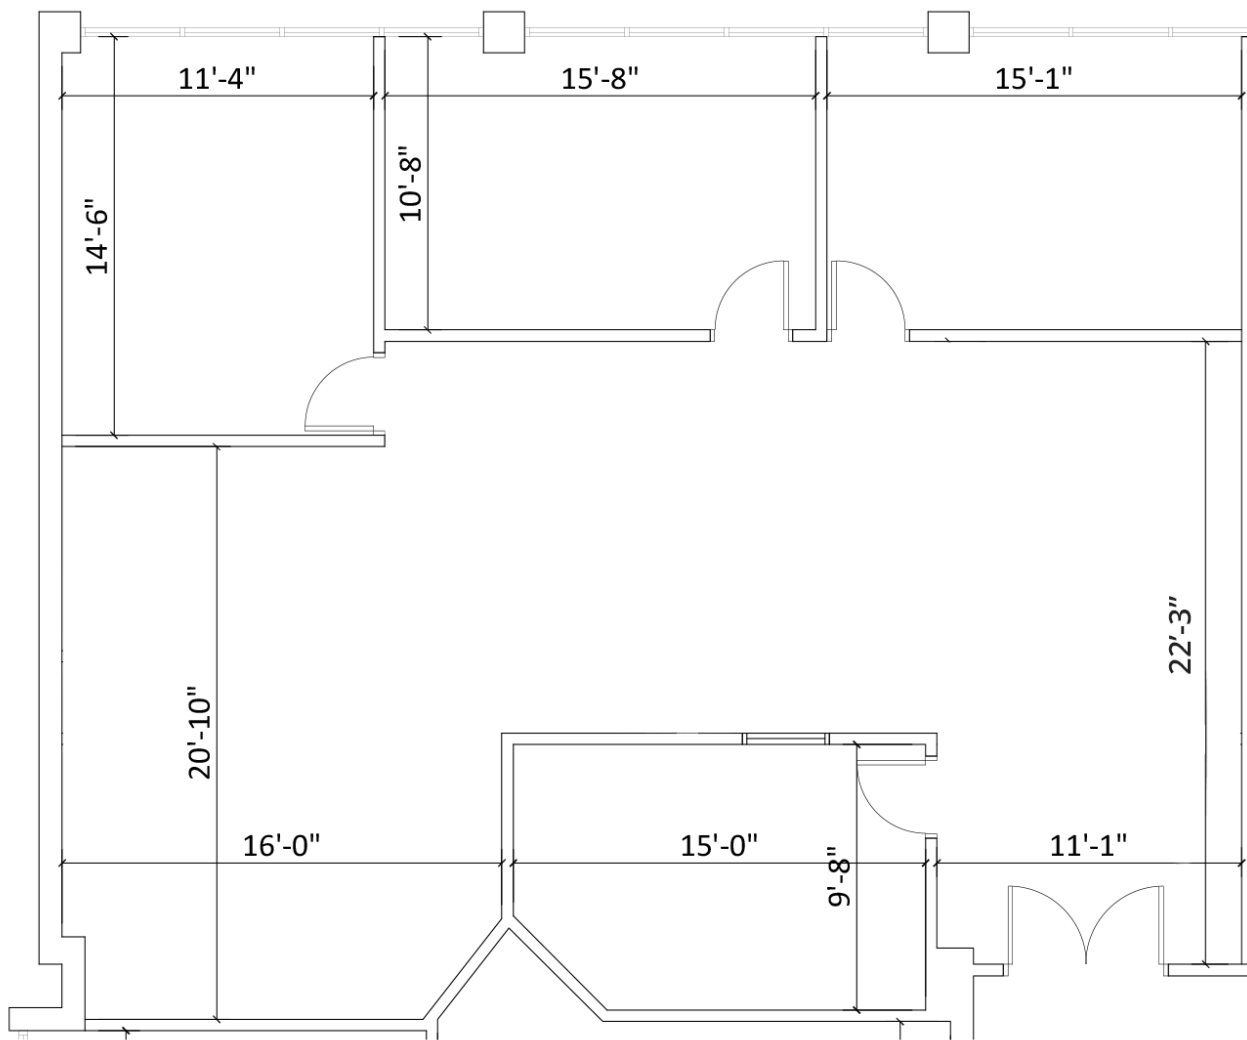

**WESTSHORE CITY CENTER**  
1211 N. Westshore Blvd  
Tampa, FL 33607

No warranty or representation, expressed or implied, is made to the accuracy of information contained herein, and same is submitted subject to errors, change of price, rental or other conditions, withdrawal without notice, and to any special listing conditions imposed by our principals. PLANS NOT TO SCALE

**MATT ALEXANDER** | DIRECTOR  
Matthew.Alexander@FranklinSt.com | 813.559.2006

**LORENZO GONZALEZ** | SENIOR ASSOCIATE  
813.793.8421 | Lorenzo.Gonzalez@FranklinSt.com

**FranklinStreet**  
Licensed Real Estate Broker | FranklinSt.com