

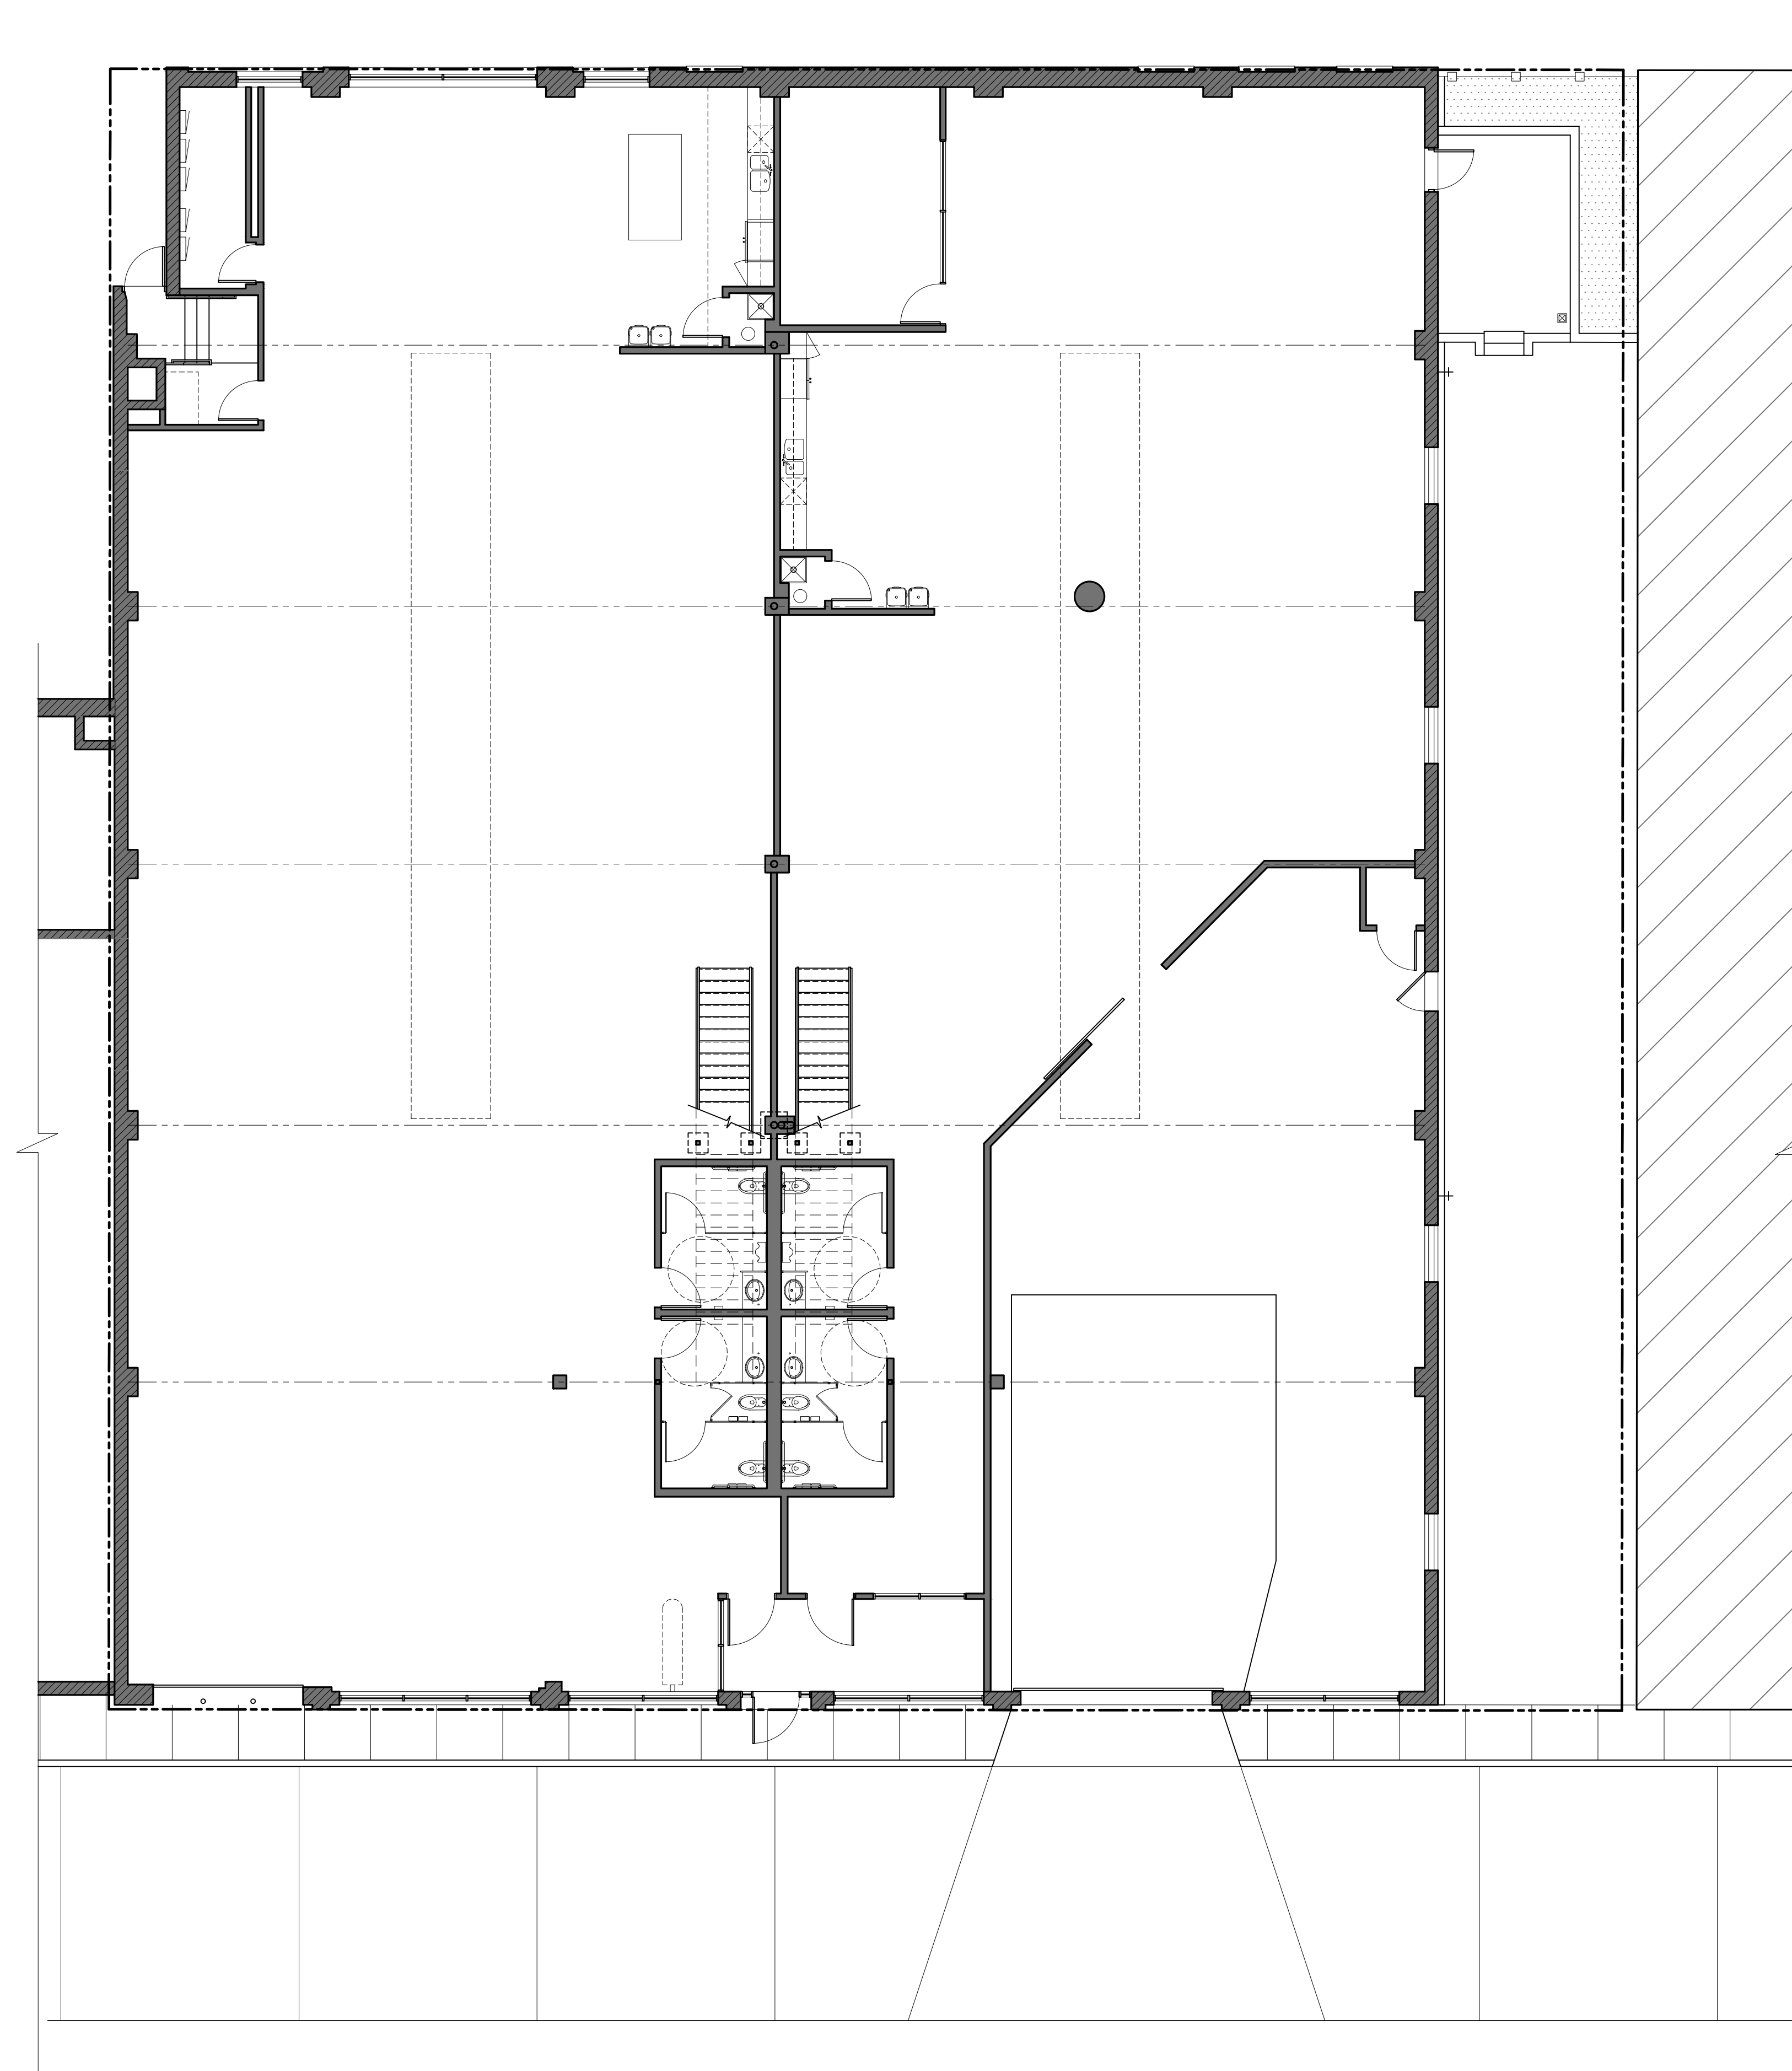


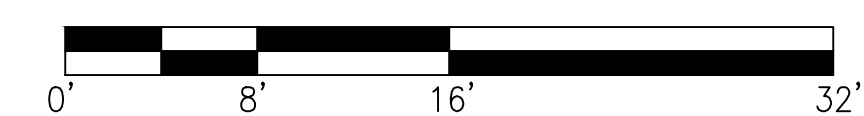

1 FIRST FLOOR PLAN
SCALE: 1/8"= 1'-0"

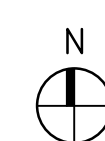

GENERAL NOTES:

- [Solid line] = EXISTING WALL TO REMAIN
- [Hatched line] = EXISTING MASONRY WALL TO REMAIN

WDN ARCHITECTURE, llc
125 NORTH MARION ST. #204
OAK PARK, ILLINOIS 60301
PHONE: 708.386.9695

PROJECT:

1640 WEST
CARROLL
AVENUE

CHICAGO, ILLINOIS

DRAWING TITLE:

EXISTING FIRST
FLOOR PLAN

ISSUE DATES:

JOB NUMBER: 1718

A-0