




3536 N Federal Highway, Ft Lauderdale, FL 33308


2,000 to 13,000 SF Office Available

FLOOR PLANS


2ND FLOOR

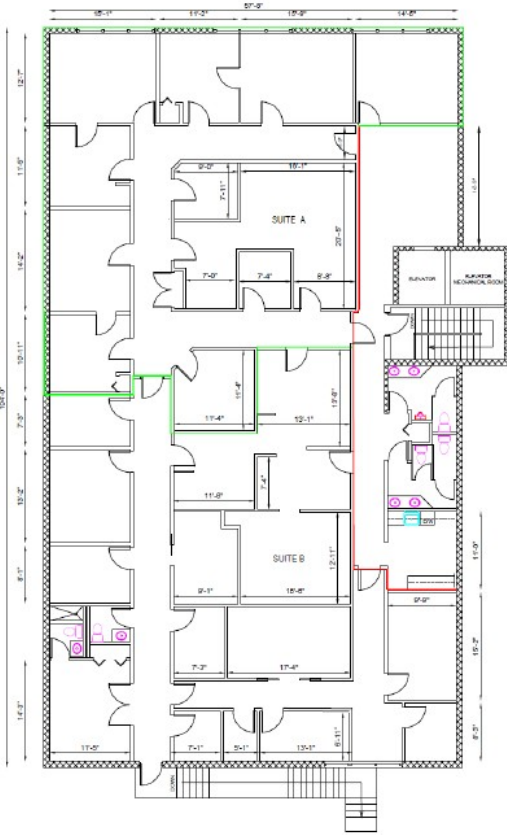


2ND FLOOR
"AS BUILT"

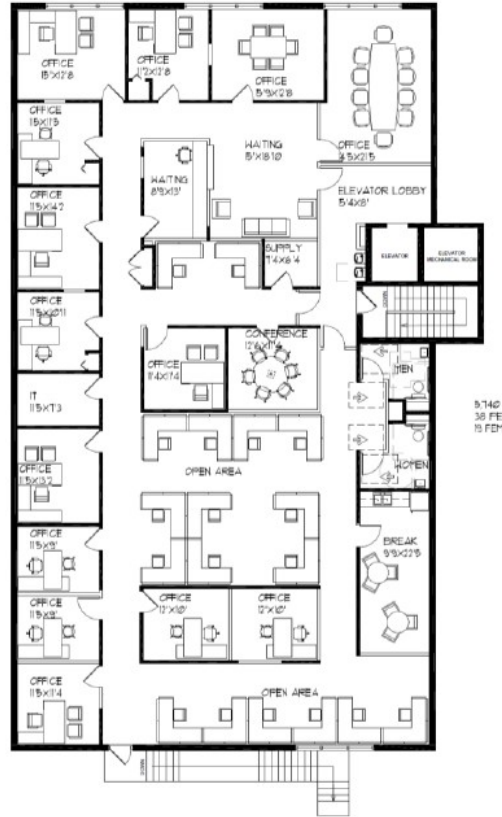

2ND FLOOR
"SCHEME 1"

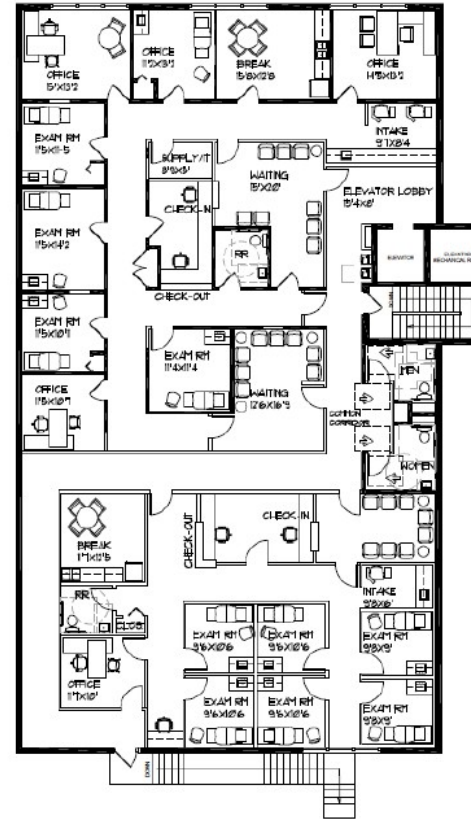

2ND FLOOR
"SCHEME 2"

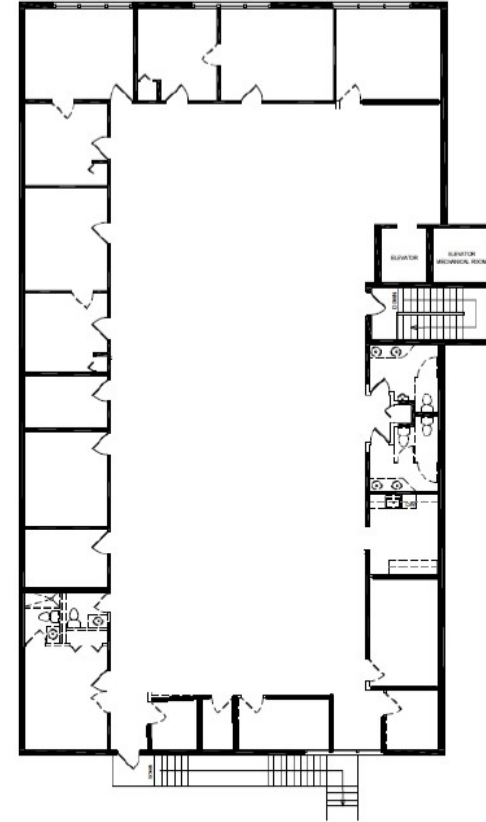

2ND FLOOR
"OPEN CONCEPT / BULL PEN"

Clint Casey | clint@rotellagroup.com
William Rotella | wjr@rotellagroup.com