


ESTRELLA
MEDICAL
CENTER

Floor 04

Suites 480
& 490
AS-BUILT

2,889 SF
AVAILABLE

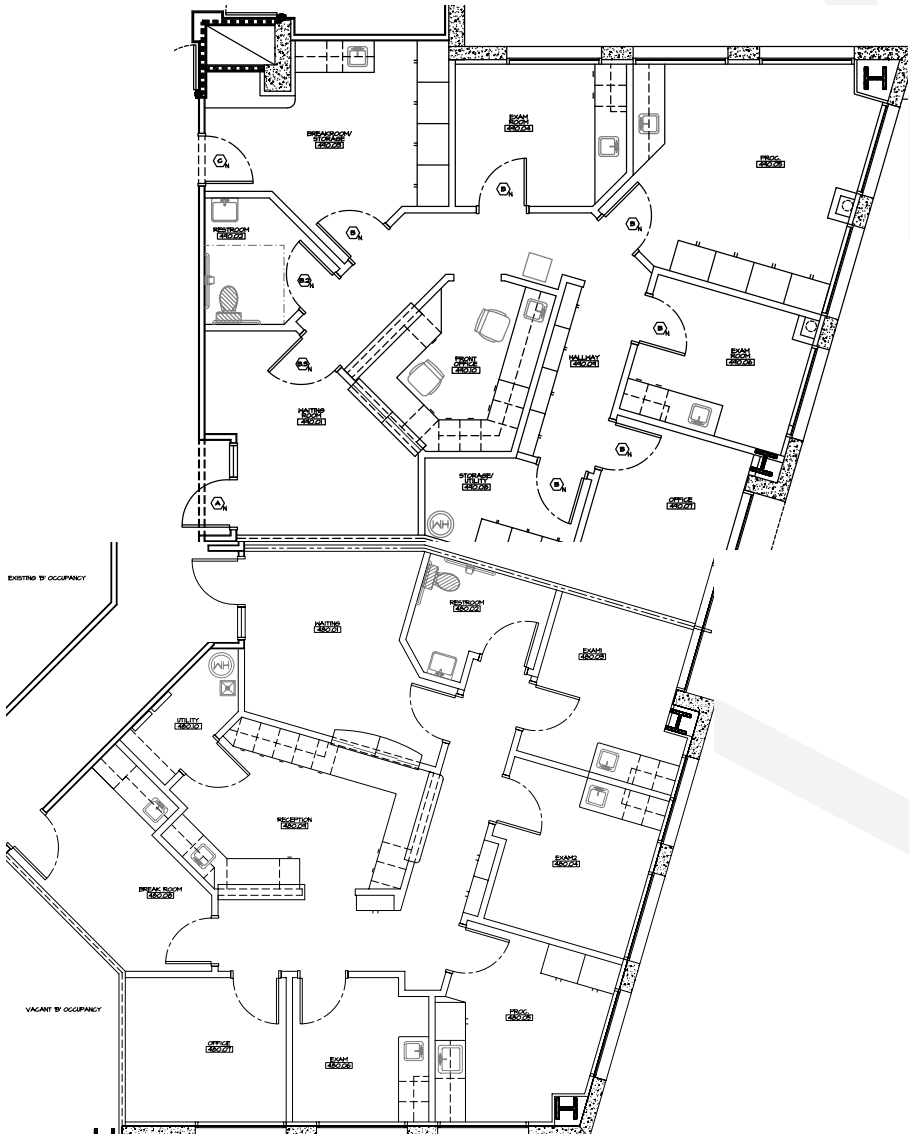

RACHAEL THOMPSON
Senior Vice President
602.513.5122
rachael.thompson@kidder.com

PERRY GABUZZI, CCIM
Senior Vice President
602.513.5116
perry.gabuzzi@kidder.com