

Monroe Business Park
10031 Monroe Drive

Suite 108
 Dallas, Texas 75229

Sheet **A6**
 Of 15 Sheet(s)



© 2025 HosScans, LLC.
 All right reserved.
 These drawings and any associated documents are protected under U.S. copyright law. No part of this work may be produced, distributed, or used in any form, by any method, for any purpose, without the prior written consent of HosScans, LLC. Unauthorized use is subject to legal action.


Scale: Not to Scale
 Sheet Size: 11" x 8.5"
 Not For Construction

Usable Square Foot Analysis

	SQFT	BUILDING PERCENTAGE
OFFICE AREA:	397	17%
WAREHOUSE AREA:	1,968	83%
TOTAL AREA:	2,365	

Building Information

Deck Height:	20'0"
Clear Height:	18'0"
Ceiling Height:	9'0"
Sprinklered:	No
Mechanical Area:	N/A

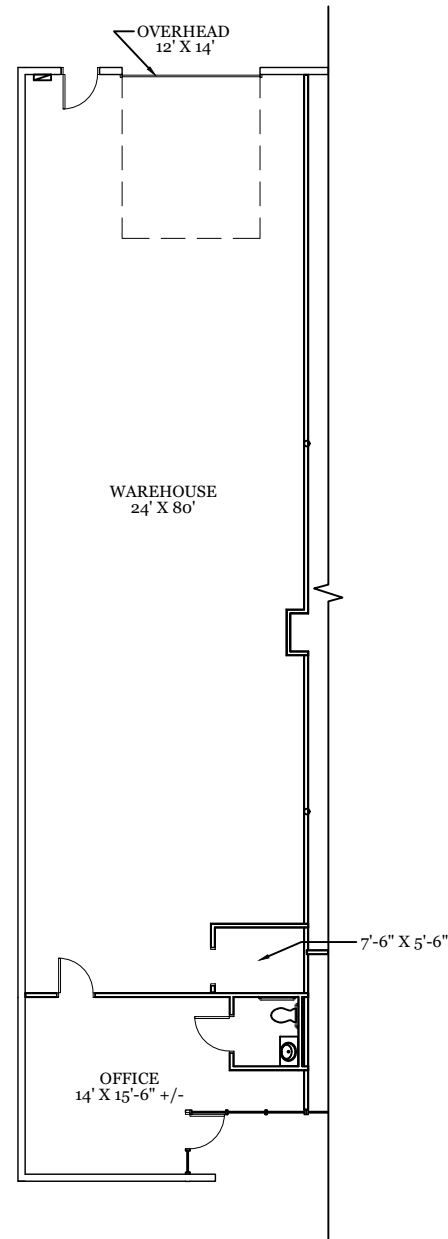

As Built Floor Plan for Marketing

