



KEY PLAN

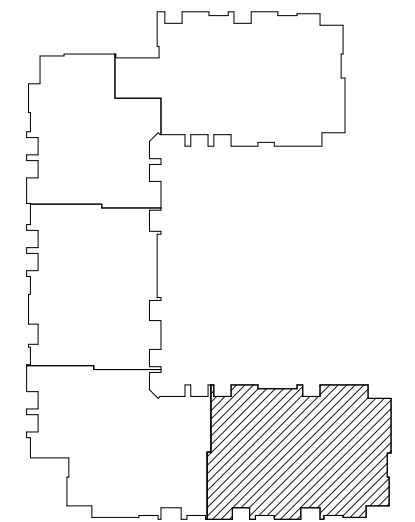

ISSUED  
ISSUED FOR BID - SEPT. 11, 2019  
ISSUED FOR PLAN REVIEW - OCT. 16, 2019  
ISSUED FOR CONSTRUCTION - NOV. 26, 2019

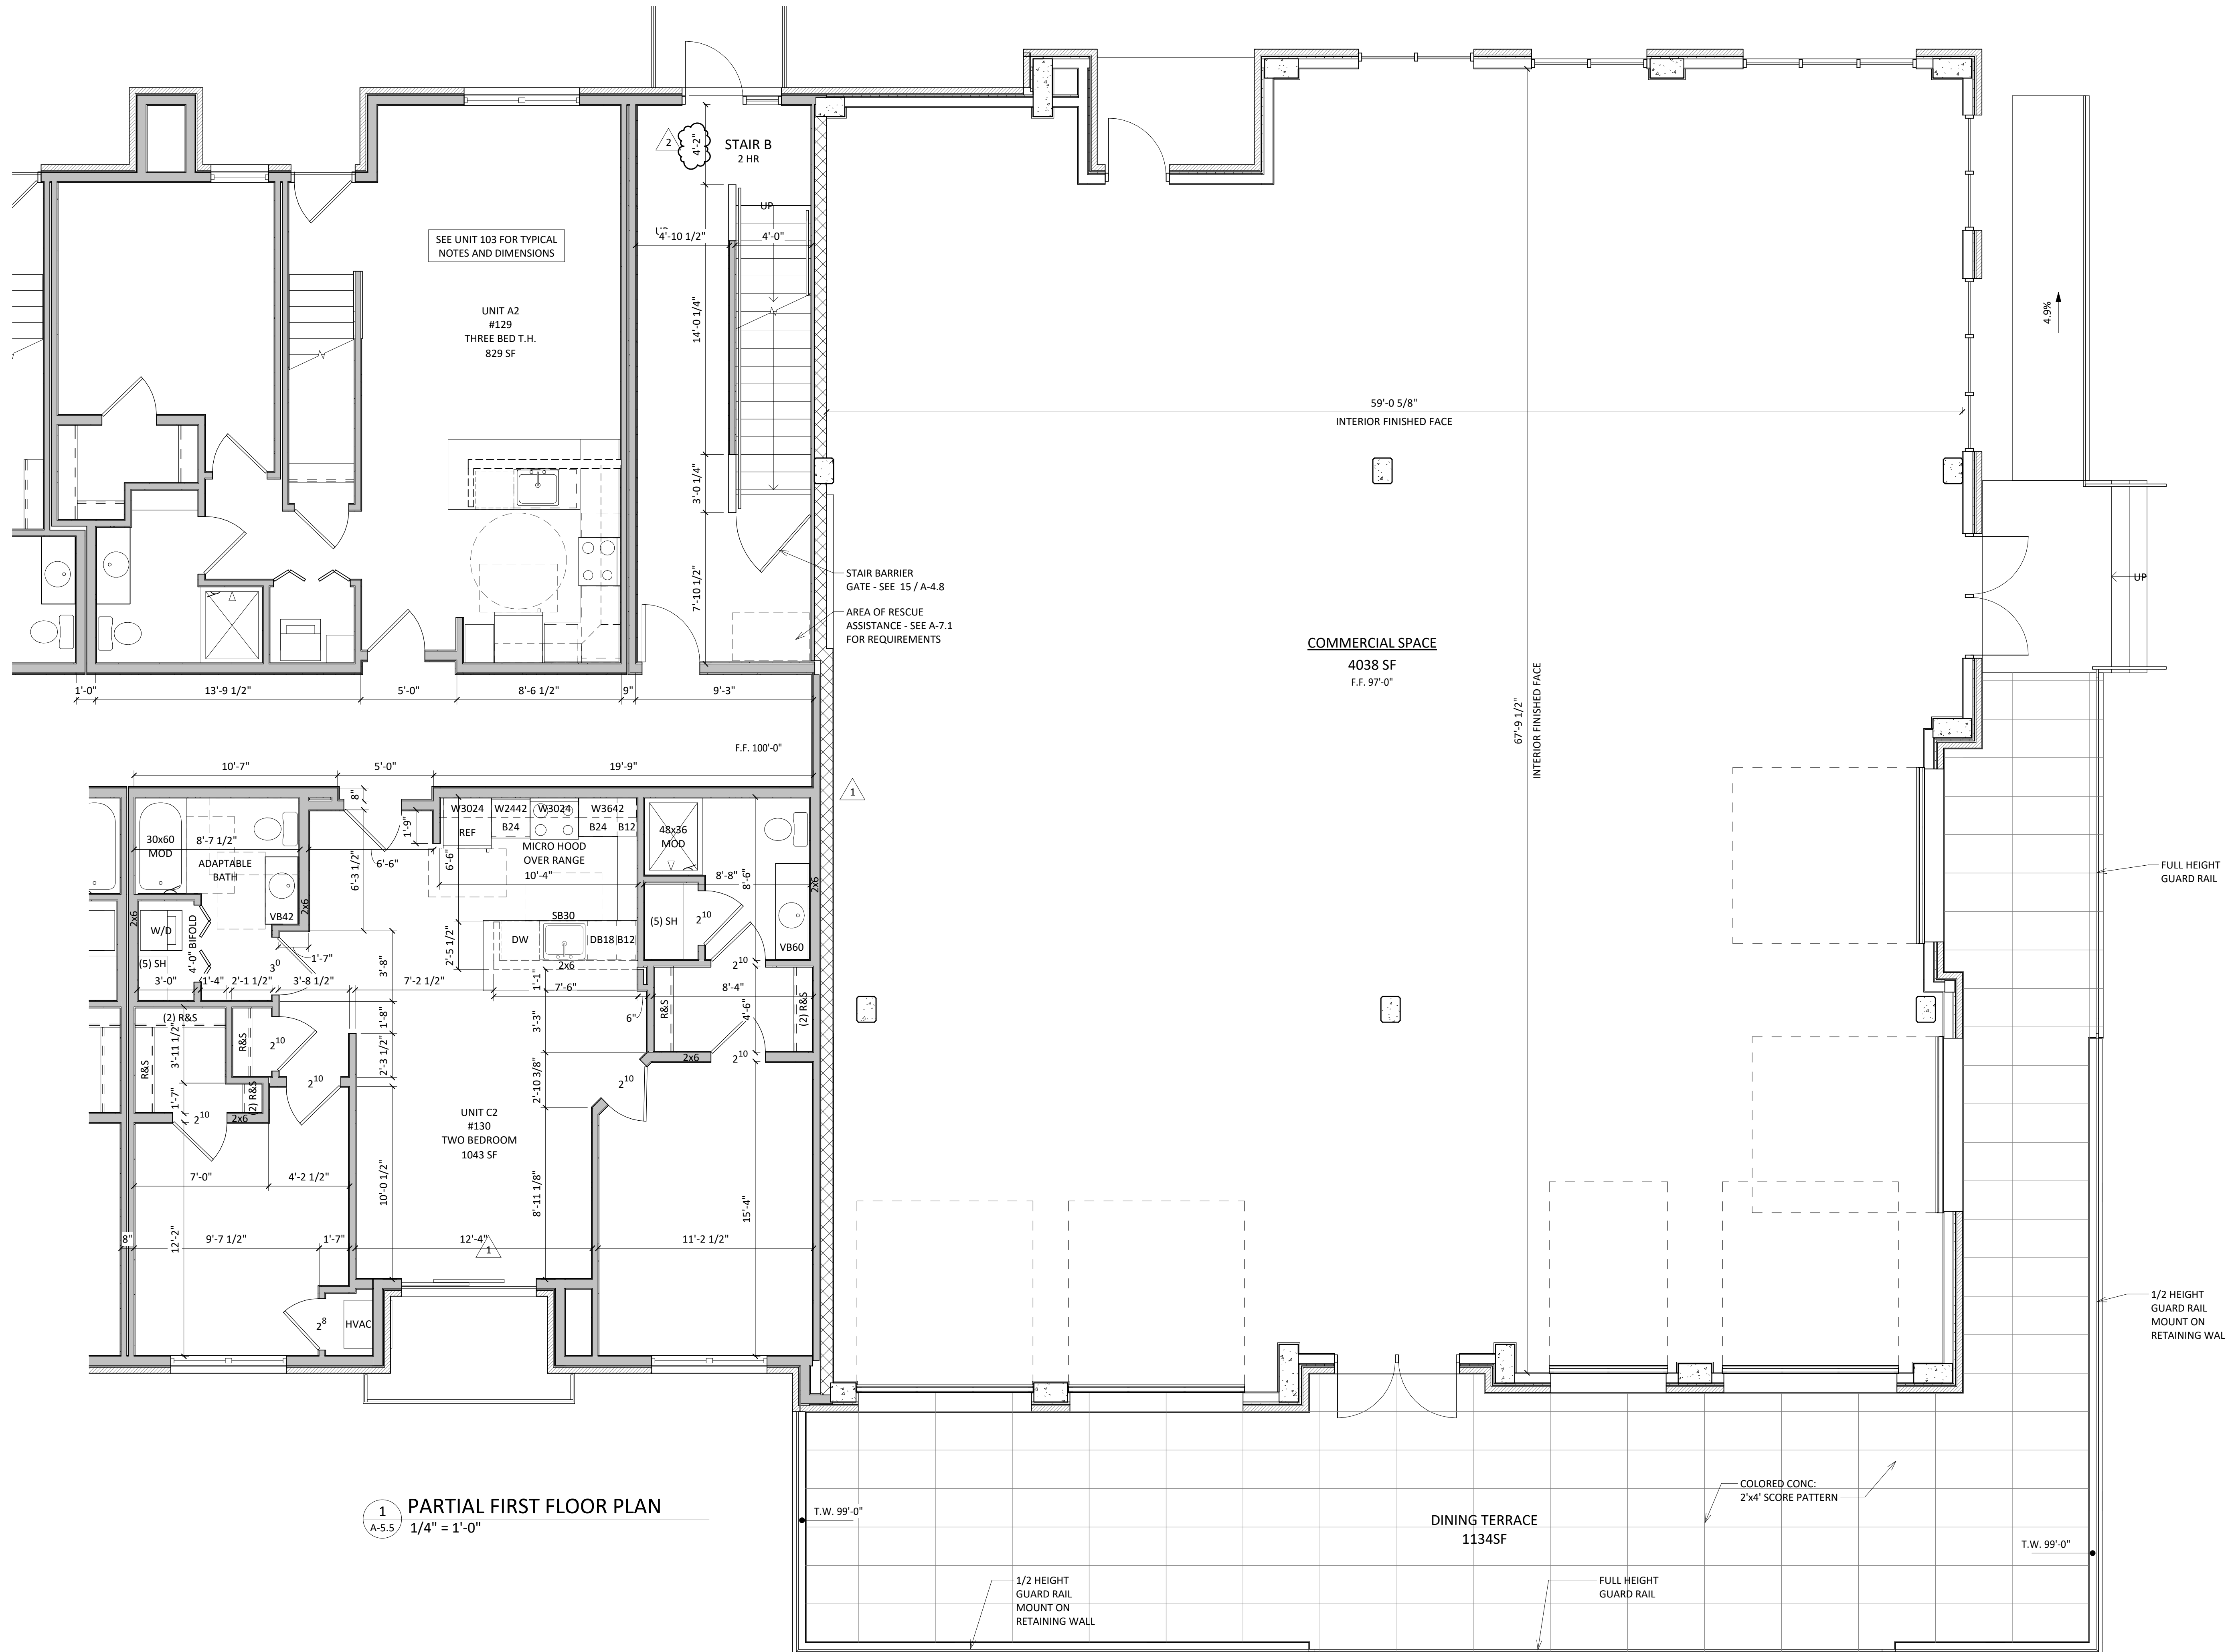

**1** PARTIAL FIRST FLOOR PLAN  
A-5.5 1/4" = 1'-0"

2 CONSTRUCTION 11.26.2019  
BULLETIN 01  
1 ADDENDUM 01 09.23.2019

PROJECT TITLE  
**SCHROEDER  
ROAD  
APARTMENTS**

5630 SCHROEDER  
RD. MADISON, WI

SHEET TITLE  
**PARTIAL FIRST  
FLOOR PLAN**

SHEET NUMBER

**A-5.5**

PROJECT NUMBER 1851  
© 2015 Knothe & Bruce Architects, LLC