


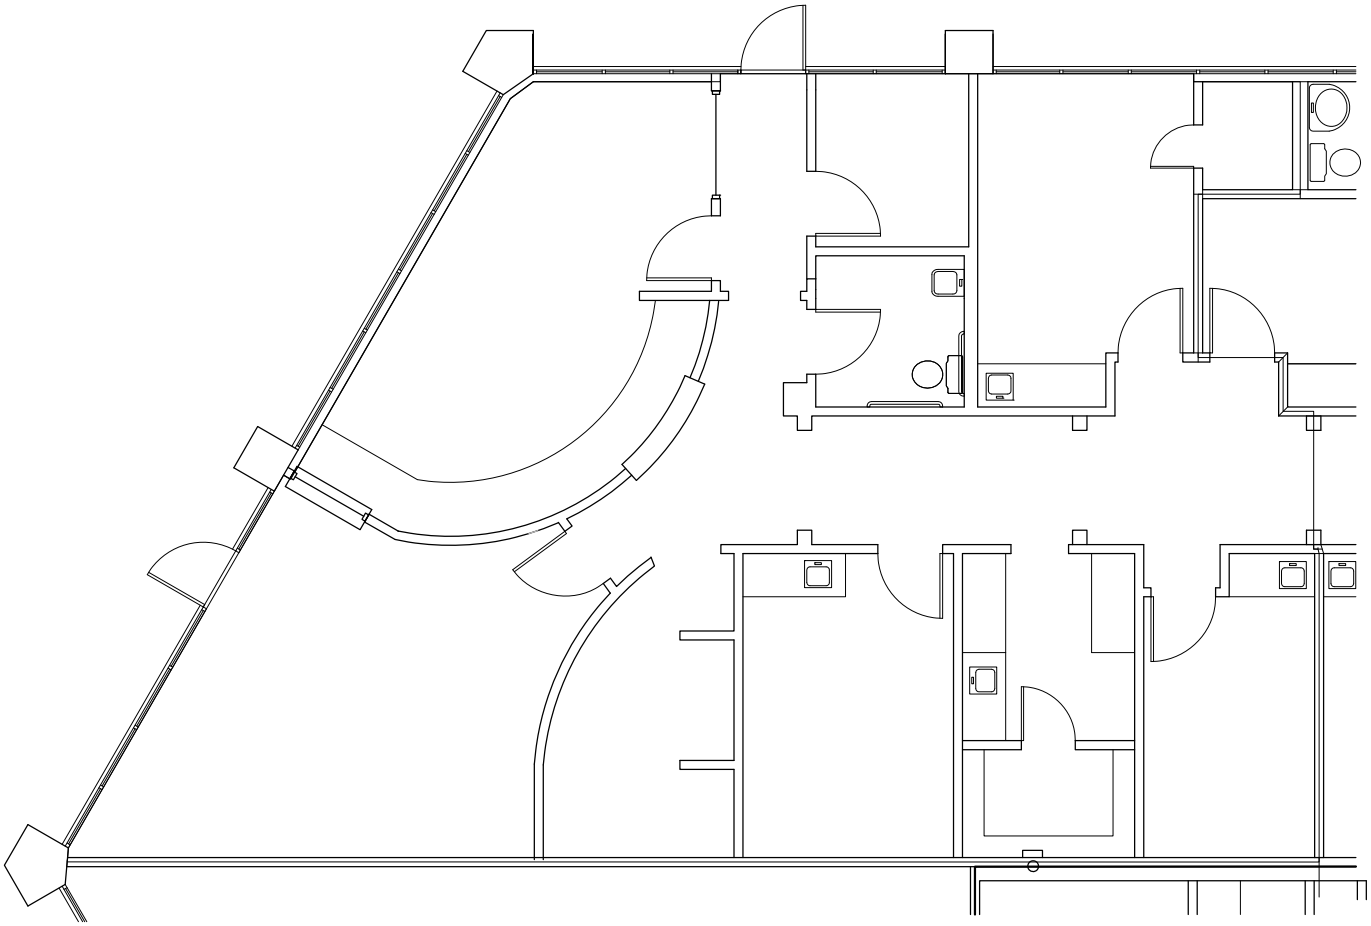

3900 W. 15th
Suite 503 - 1617 sf
As Built Plan
4.2.15