

COLONNADE  
PROFESSIONAL  
PLAZA


Floor 02

Suite 230

AS-BUILT

2,688 SF

AVAILABLE

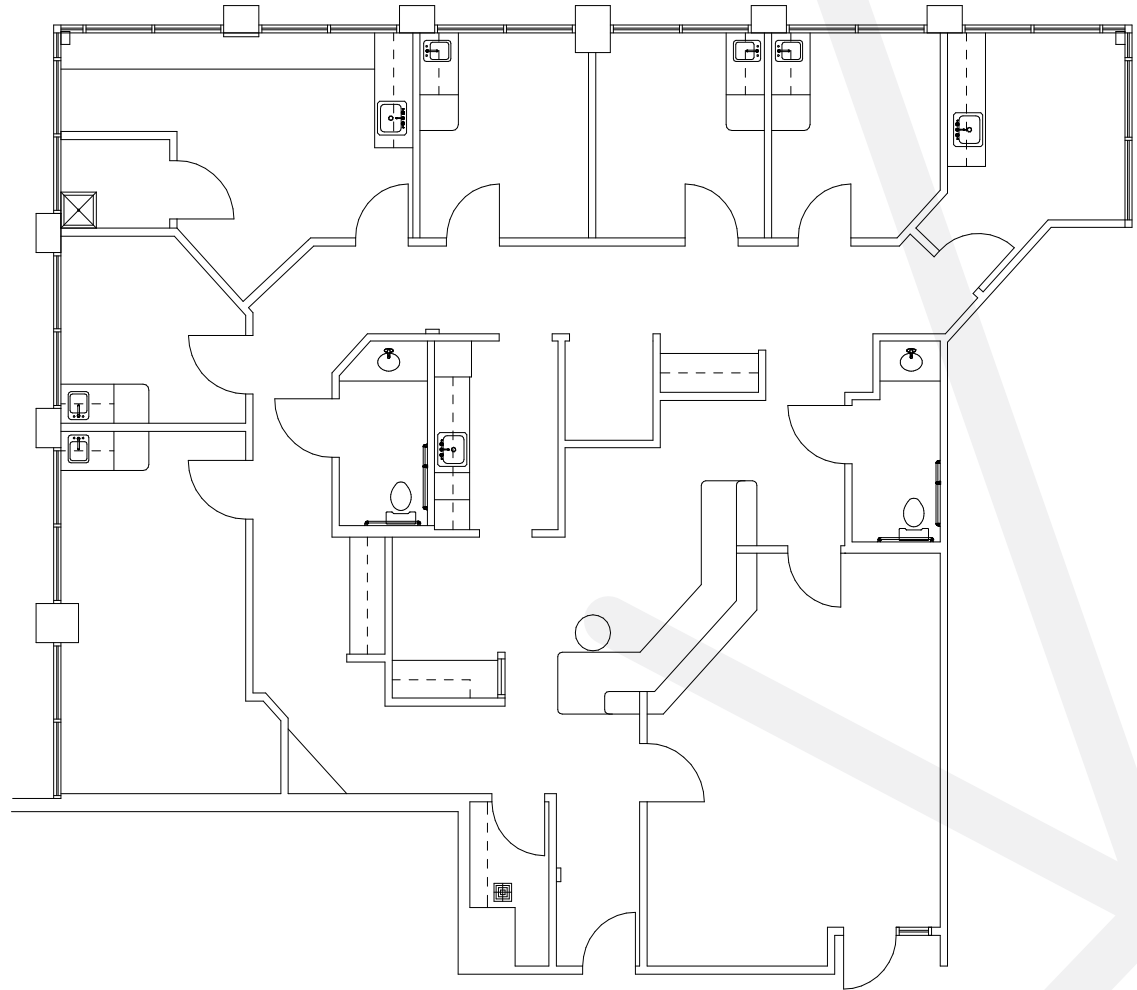

**RACHAEL THOMPSON**  
Senior Vice President  
602.513.5122  
rachael.thompson@kidder.com

**PERRY GABUZZI, CCIM**  
Executive Vice President  
602.513.5116  
perry.gabuzzi@kidder.com



View Portfolio