


Property Key

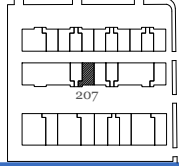


**1,729 RSF +/- As Built Marketing Package**

2750 Northaven Rd Suite 207  
Dallas, TX 75229

Sheet **A1**  
Of 1 Sheet(s)

Scale: Not to Scale  
Sheet Size: 11" x 8.5"  
Not For Construction

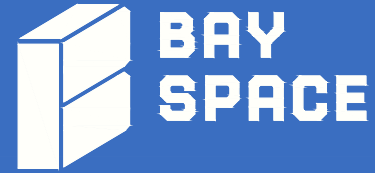


© 2025 HosScans, LLC.  
All right reserved.  
These drawings and any associated documents are protected under U.S. copyright law. No part of this work may be produced, distributed, or used in any form, by any method, for any purpose, without the prior written consent of HosScans, LLC. Unauthorized use is subject to legal action.

**Usable Square Foot Analysis**

OFFICE AREA:	781	49%
WAREHOUSE AREA:	806	51%
OVERHANG AREA:	142	
TOTAL AREA:	1,729	

**Building Information**

Deck Height:	13'10"
Clear Height:	12'4"
Ceiling Height:	8'10"
Sprinklered:	No
Mechanical Area:	N/A

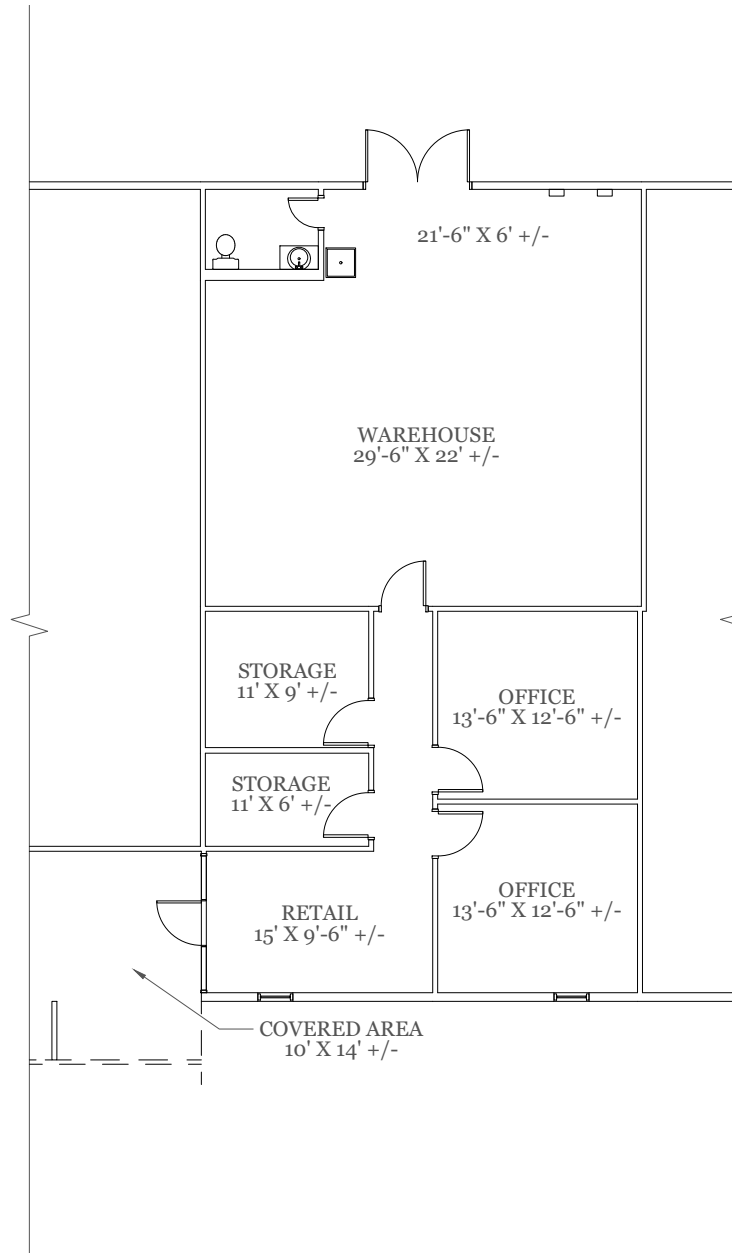

As Built Floor Plan for Marketing

