


2 SUITE J SECOND FLOOR PLAN
1/4" = 1'-0"

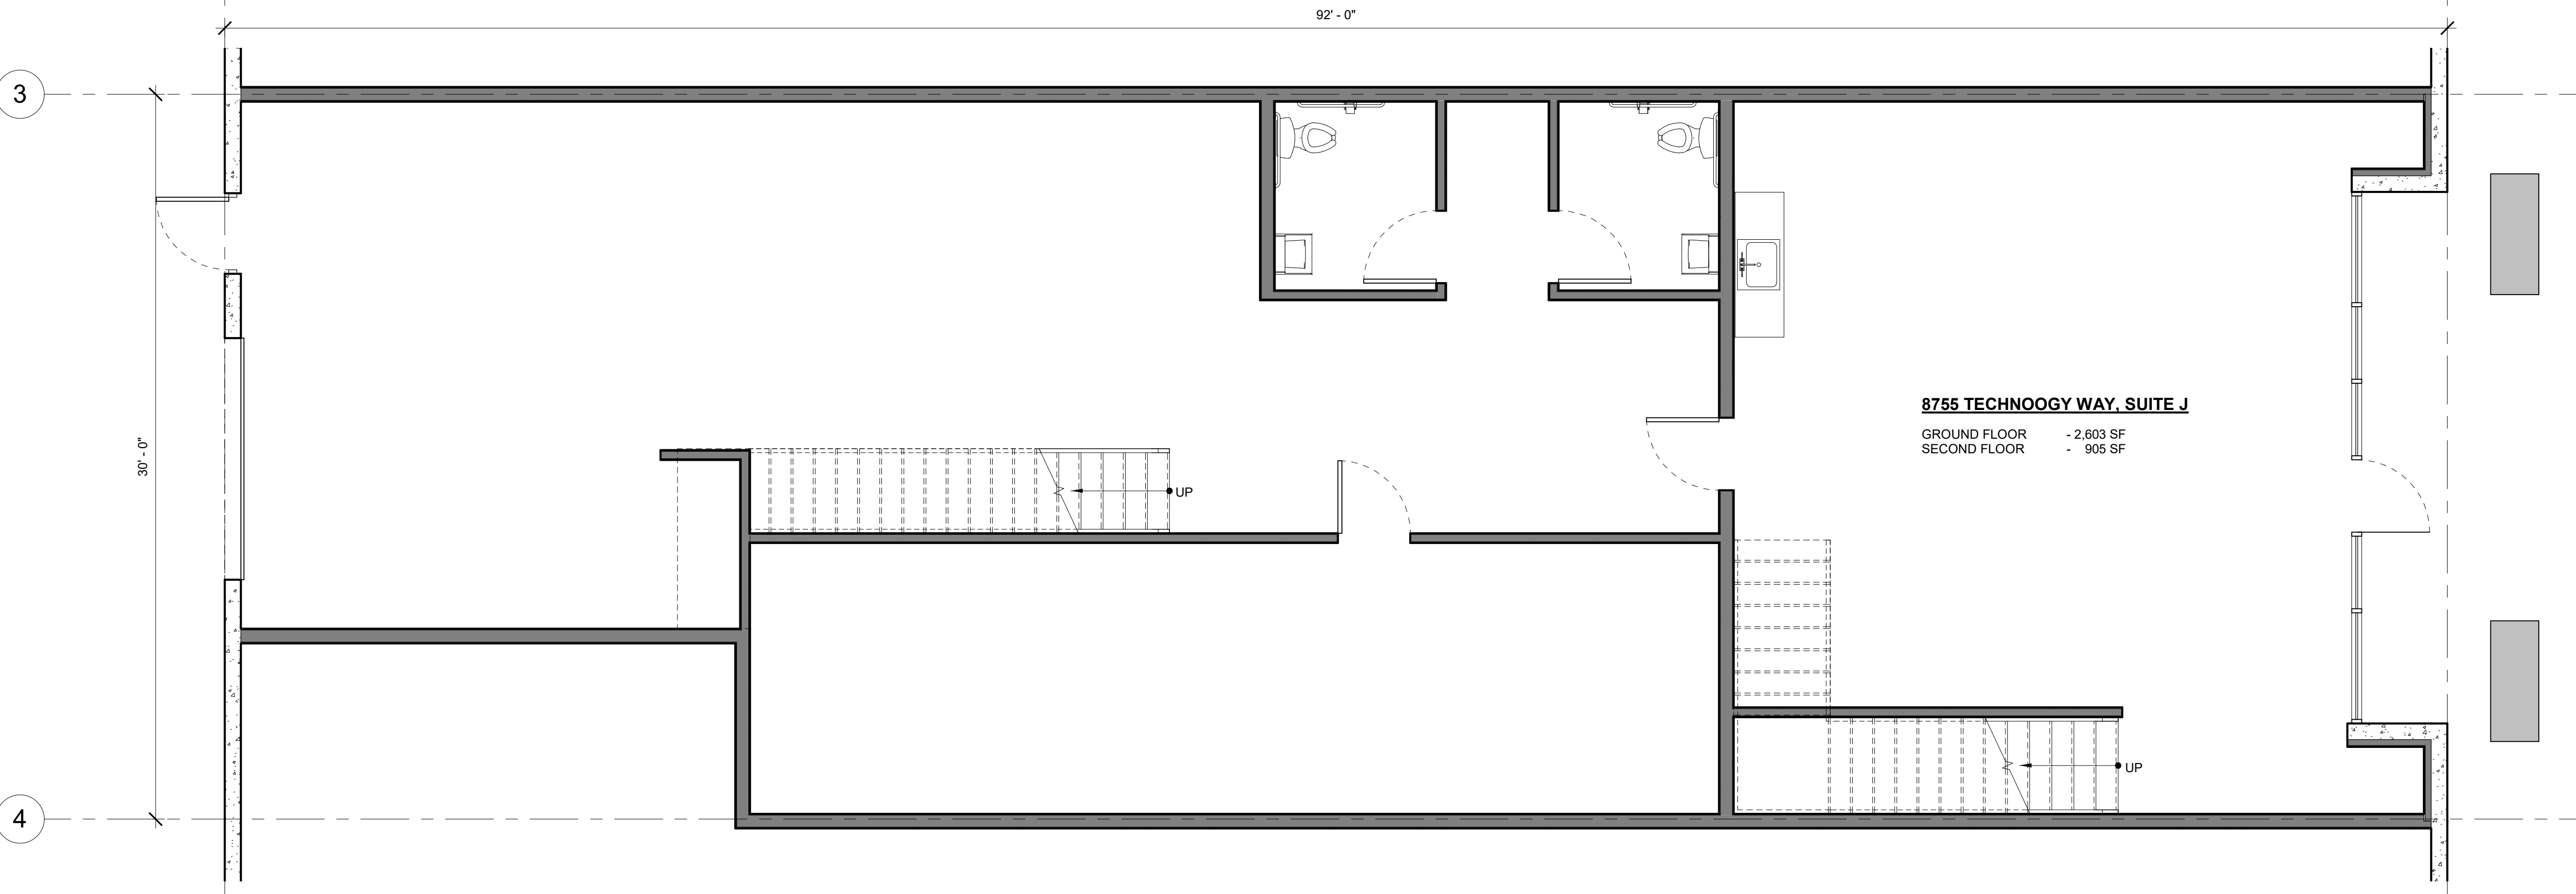

1 SUITE J FLOOR PLAN
1/4" = 1'-0"

8755 TECHNOOGY WAY, SUITE J
GROUND FLOOR - 2,603 SF
SECOND FLOOR - 905 SF

General Notes

No.	Revision/Issue	Date

Seal:

Architect:
**JOEY LASSONDE DRAFTING
AND Design**
775-527-2483
1975 SELMI DRIVE, SUITE 116
RENO, NEVADA 89512

Copyright 2020 All Rights Reserved
Drawings, specifications and other documents including those in electronic form, prepared by the architect are Instruments of Service for use solely with respect to this Project. The Architect shall be deemed the author and owner of these instruments of Service and shall retain all common law, statutory and other reserved rights, including copyrights.

Project Name and Address
SUITE J RECORD PLAN
8755 TECHNOOGY WAY
RENO, NEVADA

Title
FLOOR PLAN

Approvals

Date 05/11/2022	Job Number	Sheet A2.1
Scale 1/4" = 1'-0"		