


KEY PLAN

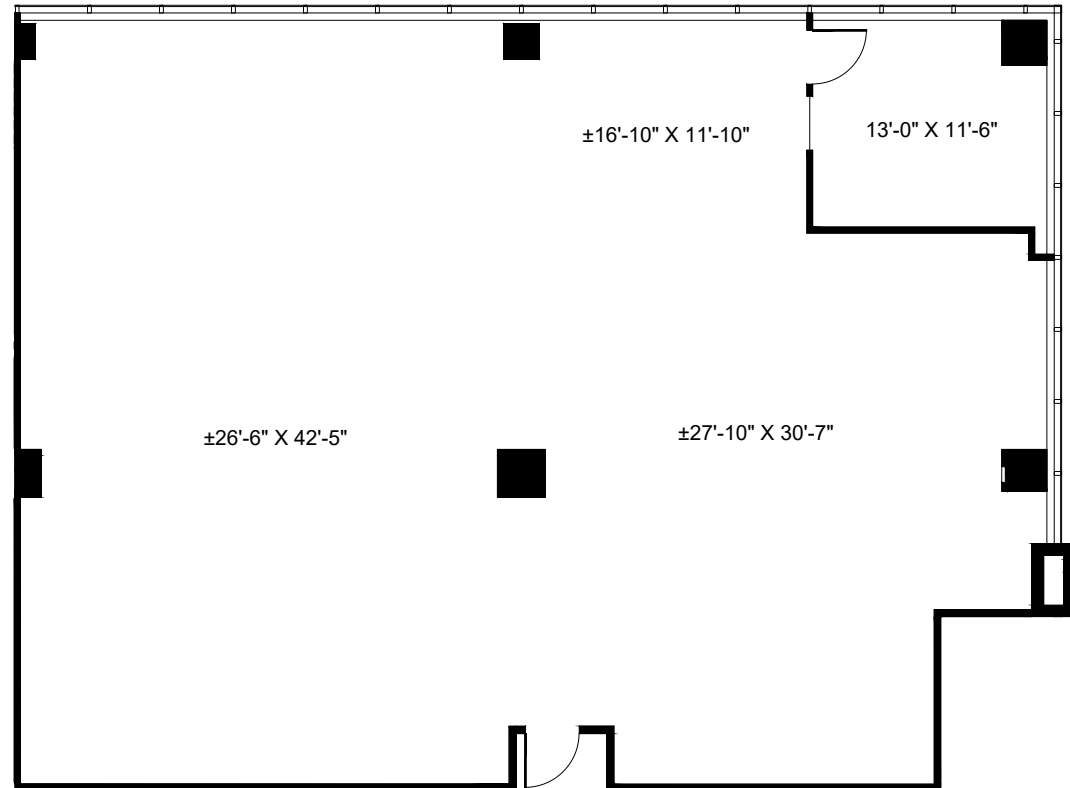

# Lincoln

4040 NCX  
DALLAS, TEXAS

AS-BUILT PLAN  
SUITE 240

rsf: 2,926

scale: 3/32" = 1'-0"

date: 04.01.2024



1201 main street  
suite 1370  
dallas, texas 75202  
214.420.4646