


**BOSWELL
WEST MEDICAL
OFFICE
BUILDING**

Floor 01

Suite 101B
AS-BUILT

1,454 SF
AVAILABLE

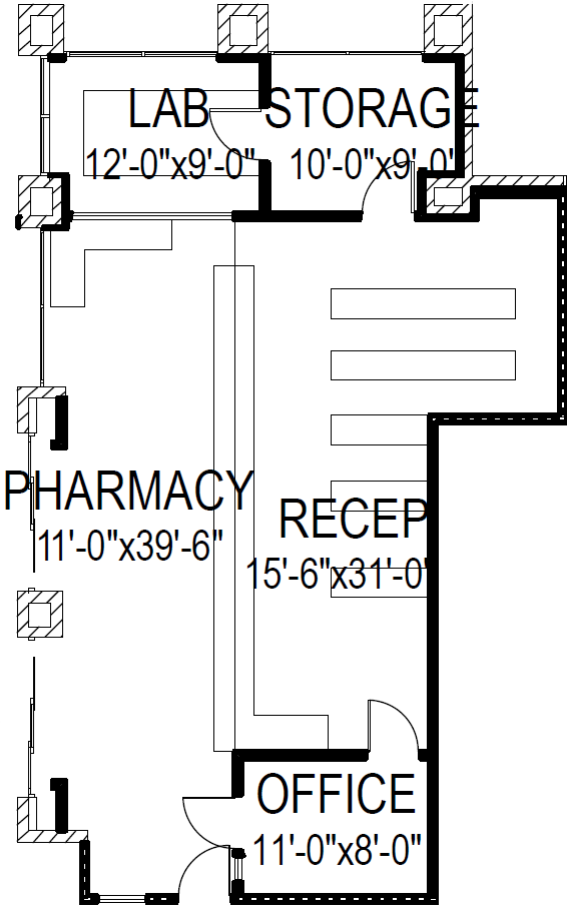

RACHAEL THOMPSON
Senior Vice President
602.513.5122
rachael.thompson@kidder.com

PERRY GABUZZI, CCIM
Senior Vice President
602.513.5116
perry.gabuzzi@kidder.com