


# LAKEVIEW MEDICAL ARTS CENTER

## Floor 1

Suite 62  
AS-BUILT

962 SF  
AVAILABLE

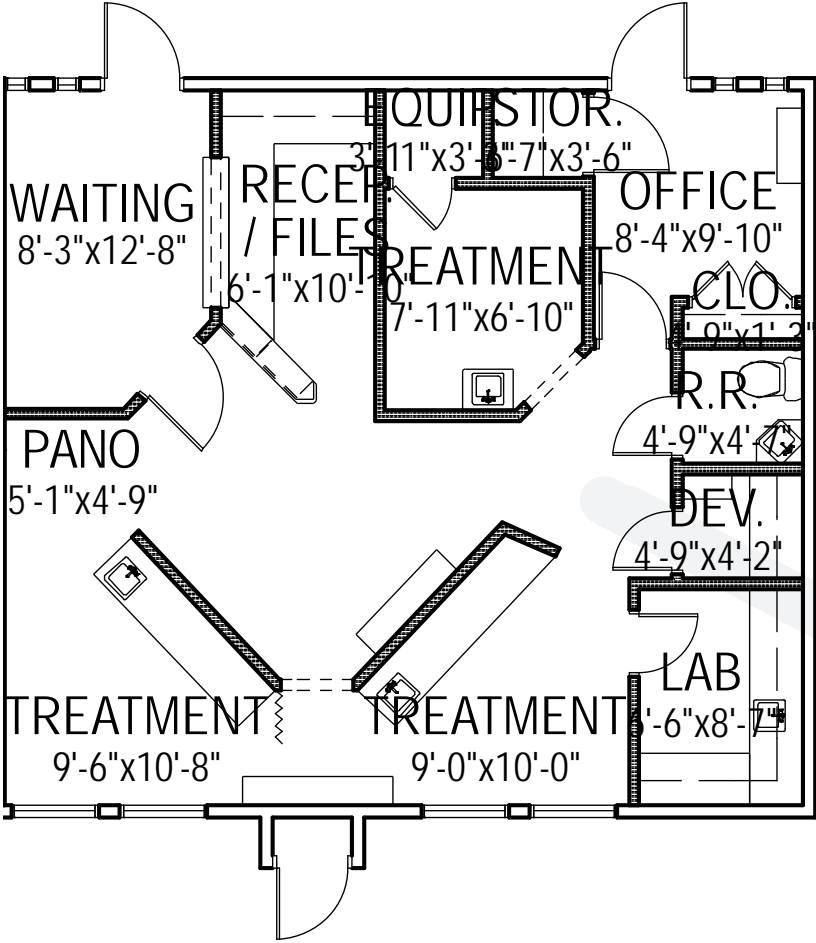

**RACHAEL THOMPSON**  
Senior Vice President  
602.513.5122  
rachael.thompson@kidder.com

**PERRY GABUZZI, CCIM**  
Senior Vice President  
602.513.5116  
perry.gabuzzi@kidder.com