


Front Entrances | Parking

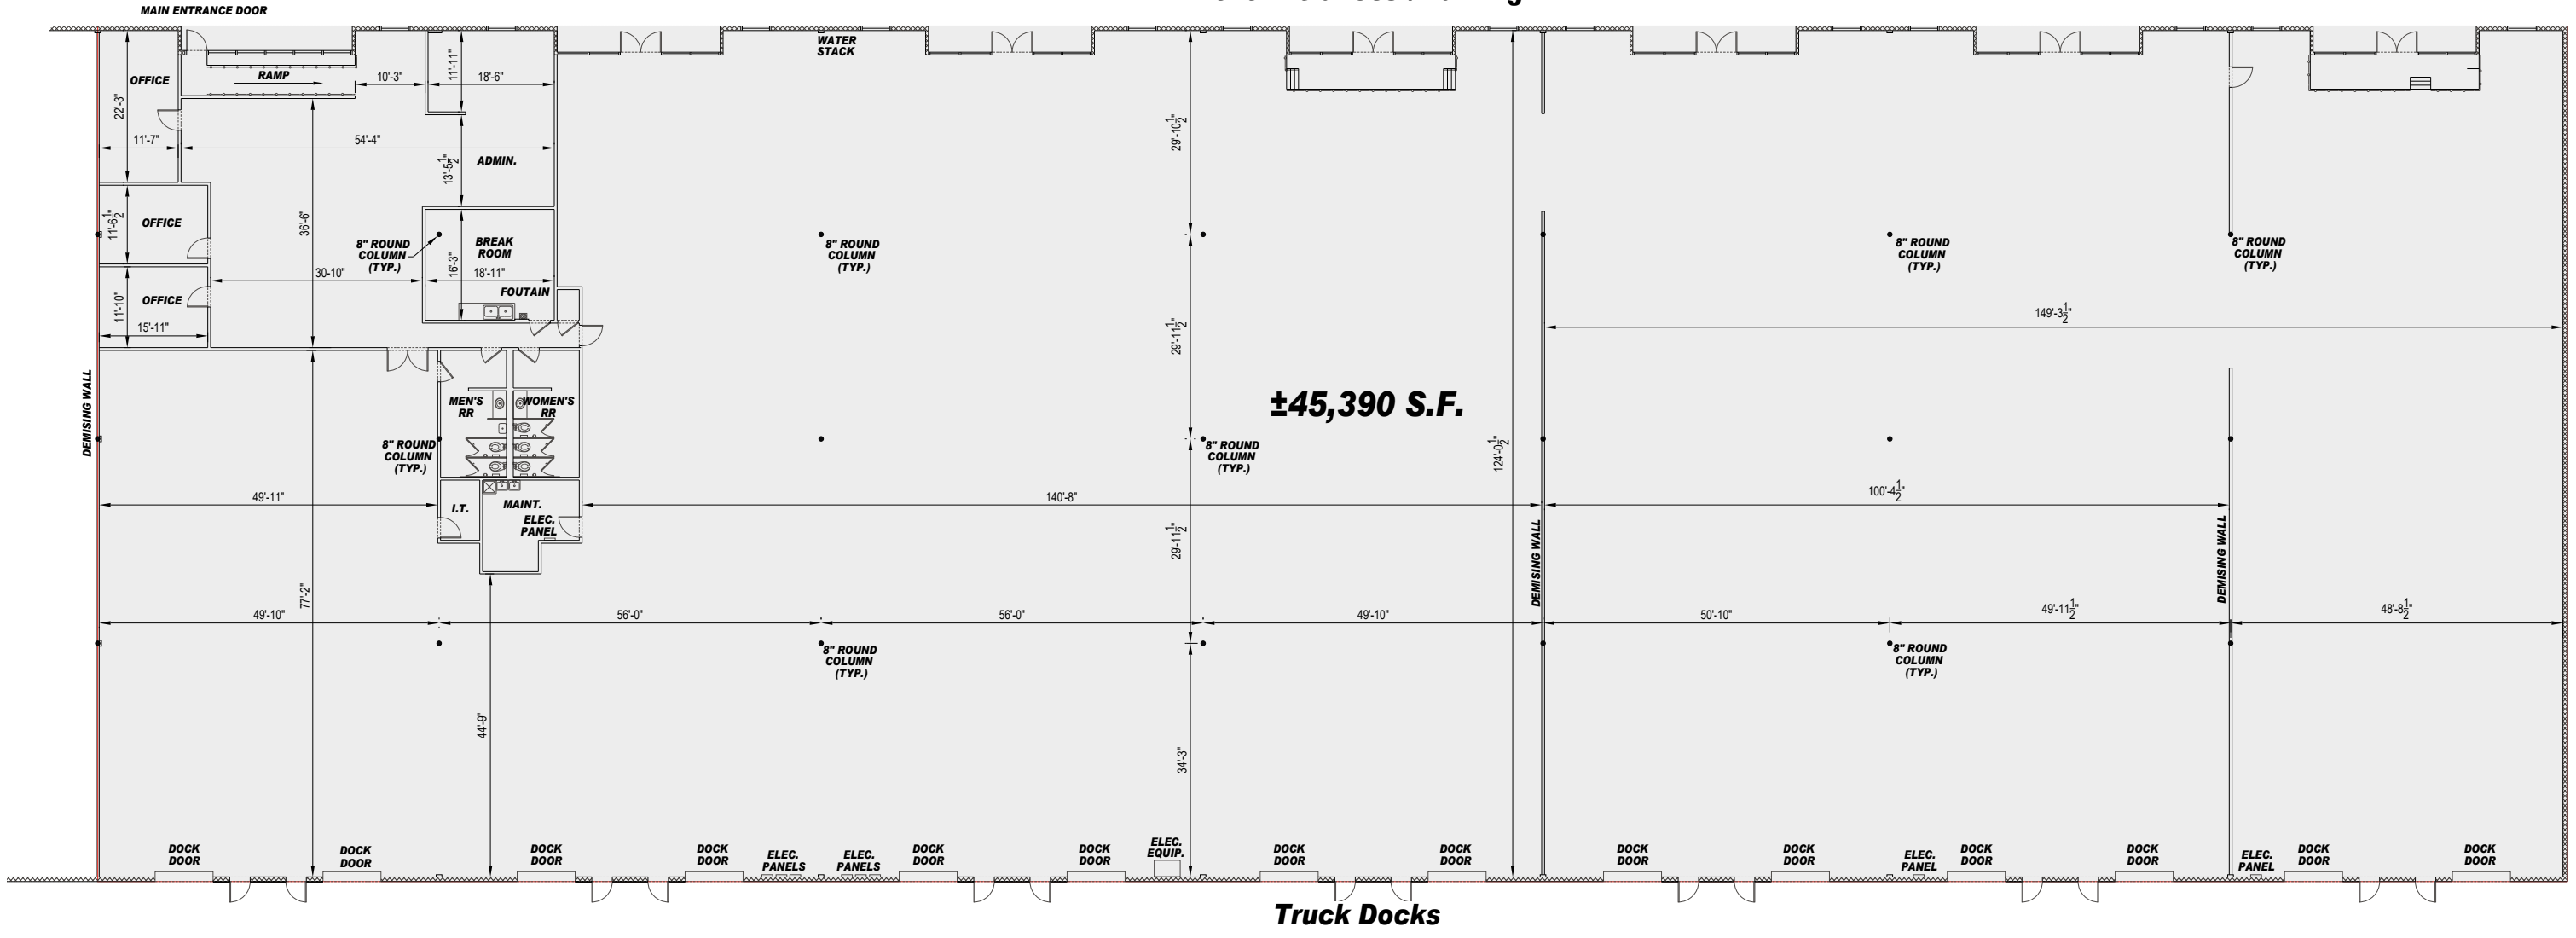

23031-As-Built.dwg © Copyright: Property Solutions

May 5, 2023
Existing As-Built
1517 TWO PLACE
MEMPHIS, TENNESSEE



RYAN EDWARDS, PROPERTY MANAGER
 6263 POPLAR AVE., STE 440
 MEMPHIS, TN 38119