


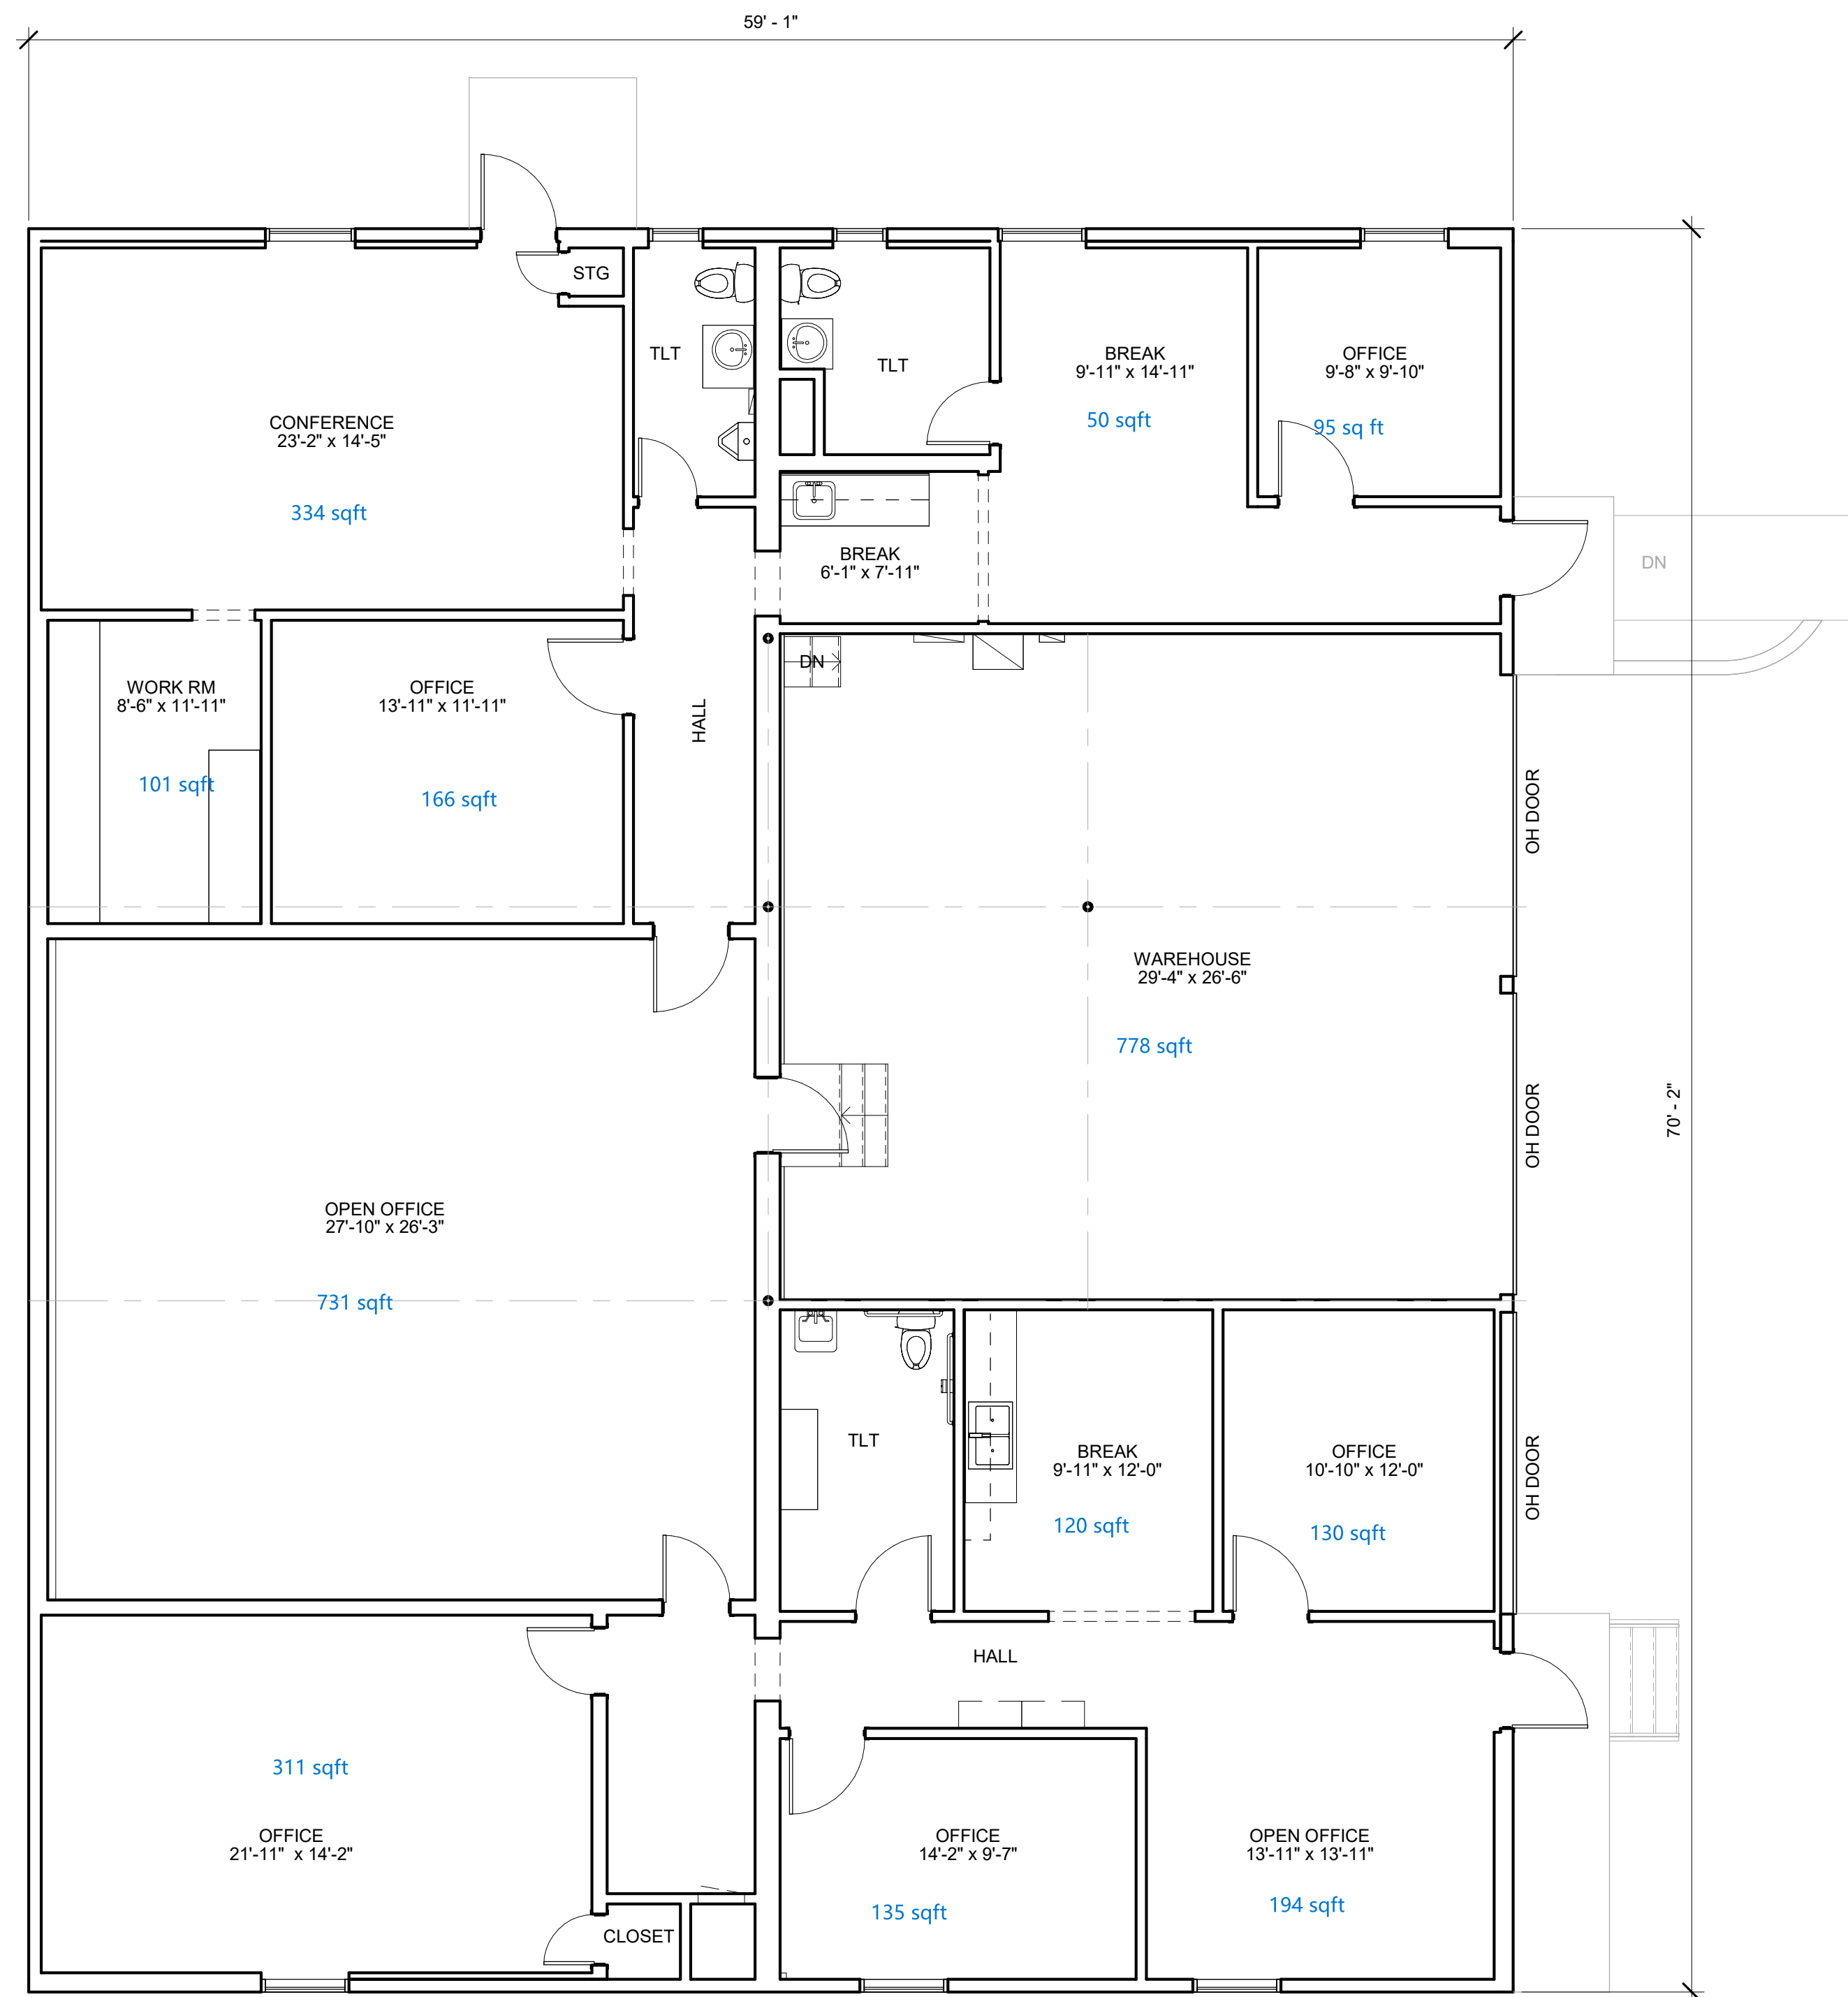

① Existing Bldg 2
3/16" = 1'-0"

15562 Capital Port - As-Built Floor Plan-Bldg. 2

15562 Capital Port Dr. San Antonio, TX 78249

Scale: 3/16" = 1'-0"

Area: 4,146 SF

02/11/25

LKDG Prj. No: 25014

LK design group

architecture . planning . interiors

16010 Via Shavano - San Antonio, Texas 78249
210.824.8825 fax 210.824.4150