

59,441 RSF +/- As Built Marketing Package

3201 Pioneer Parkway
Suite 30
Arlington, Texas 76010

Sheet **A1**
Of 3 Sheet(s)

Scale: Not to Scale
Sheet Size: 11" x 8.5"
Not For Construction




© 2025 HosScans, LLC.
All right reserved.
These drawings and any associated documents are protected under U.S. copyright law. No part of this work may be produced, distributed, or used in any form, by any method, for any purpose, without the prior written consent of HosScans, LLC. Unauthorized use is subject to legal action.

Usable Square Foot Analysis

OFFICE AREA:	920	42%
WAREHOUSE AREA:	1,276	58%
TOTAL AREA:	2,196	

Building Information

Deck Height:	12'0"
Clear Height:	10'0"
Ceiling Height:	7'11"
Sprinklered:	No
Mechanical Area:	N/A

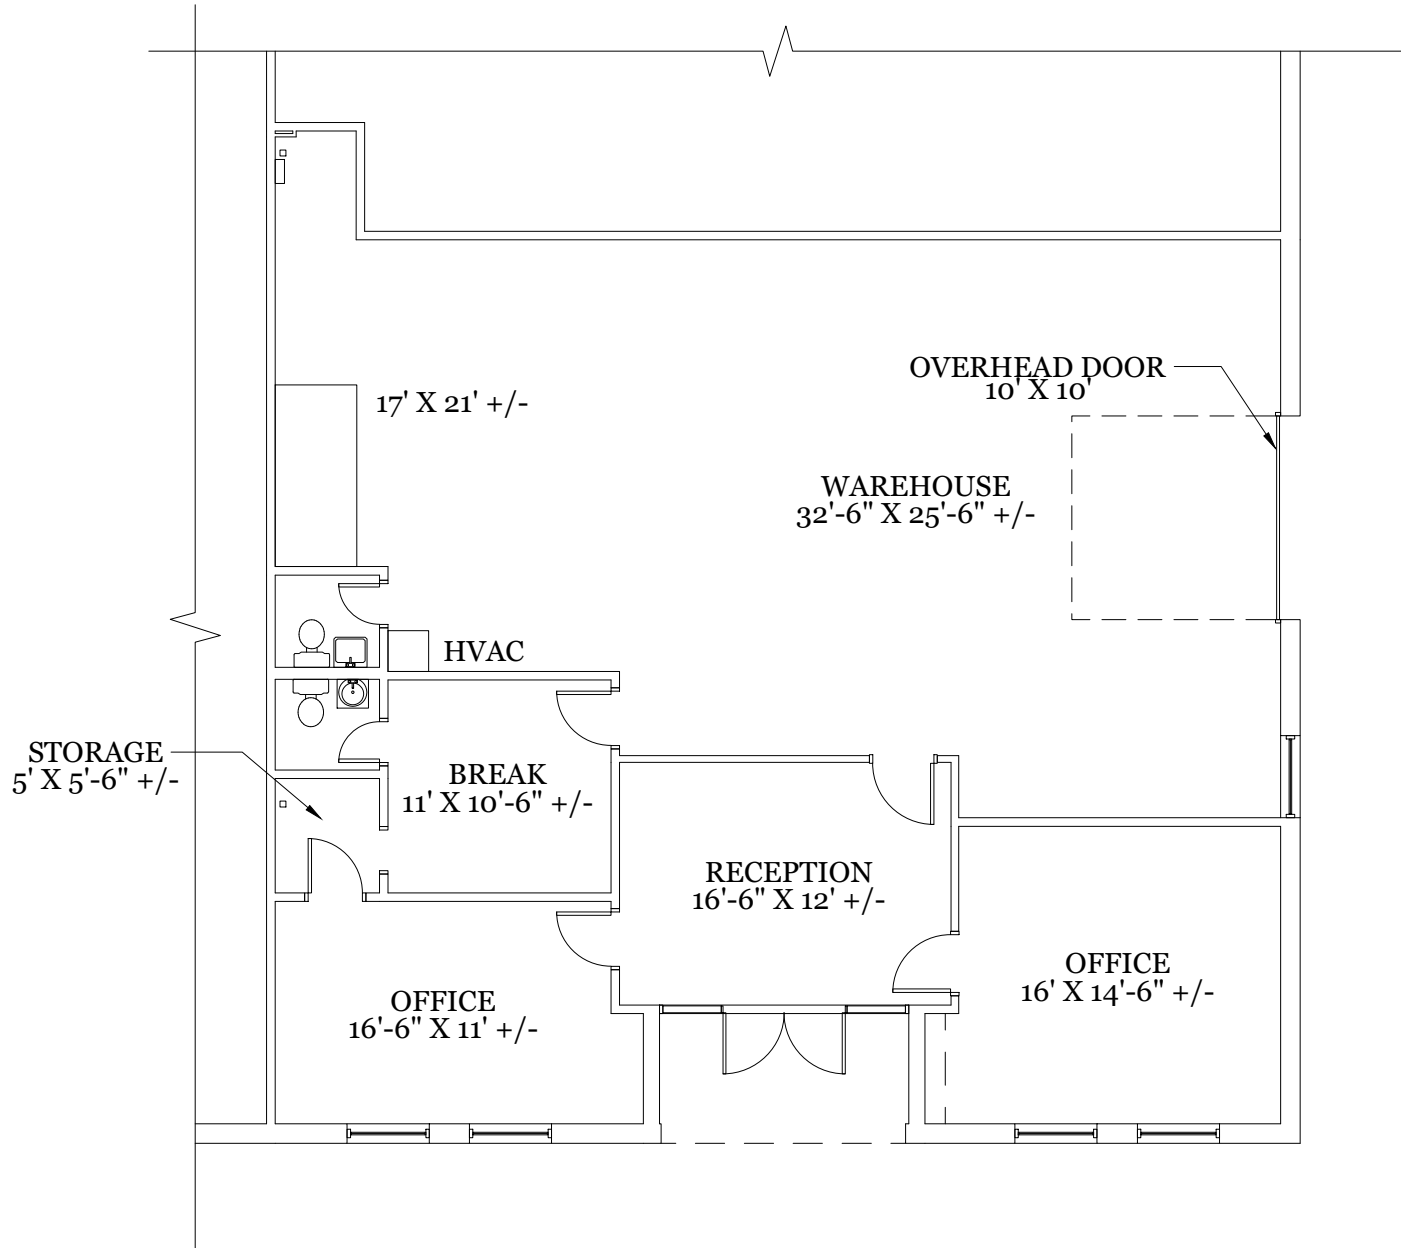

As Built Floor Plan for Marketing

