


NO.	DATE	REVISION

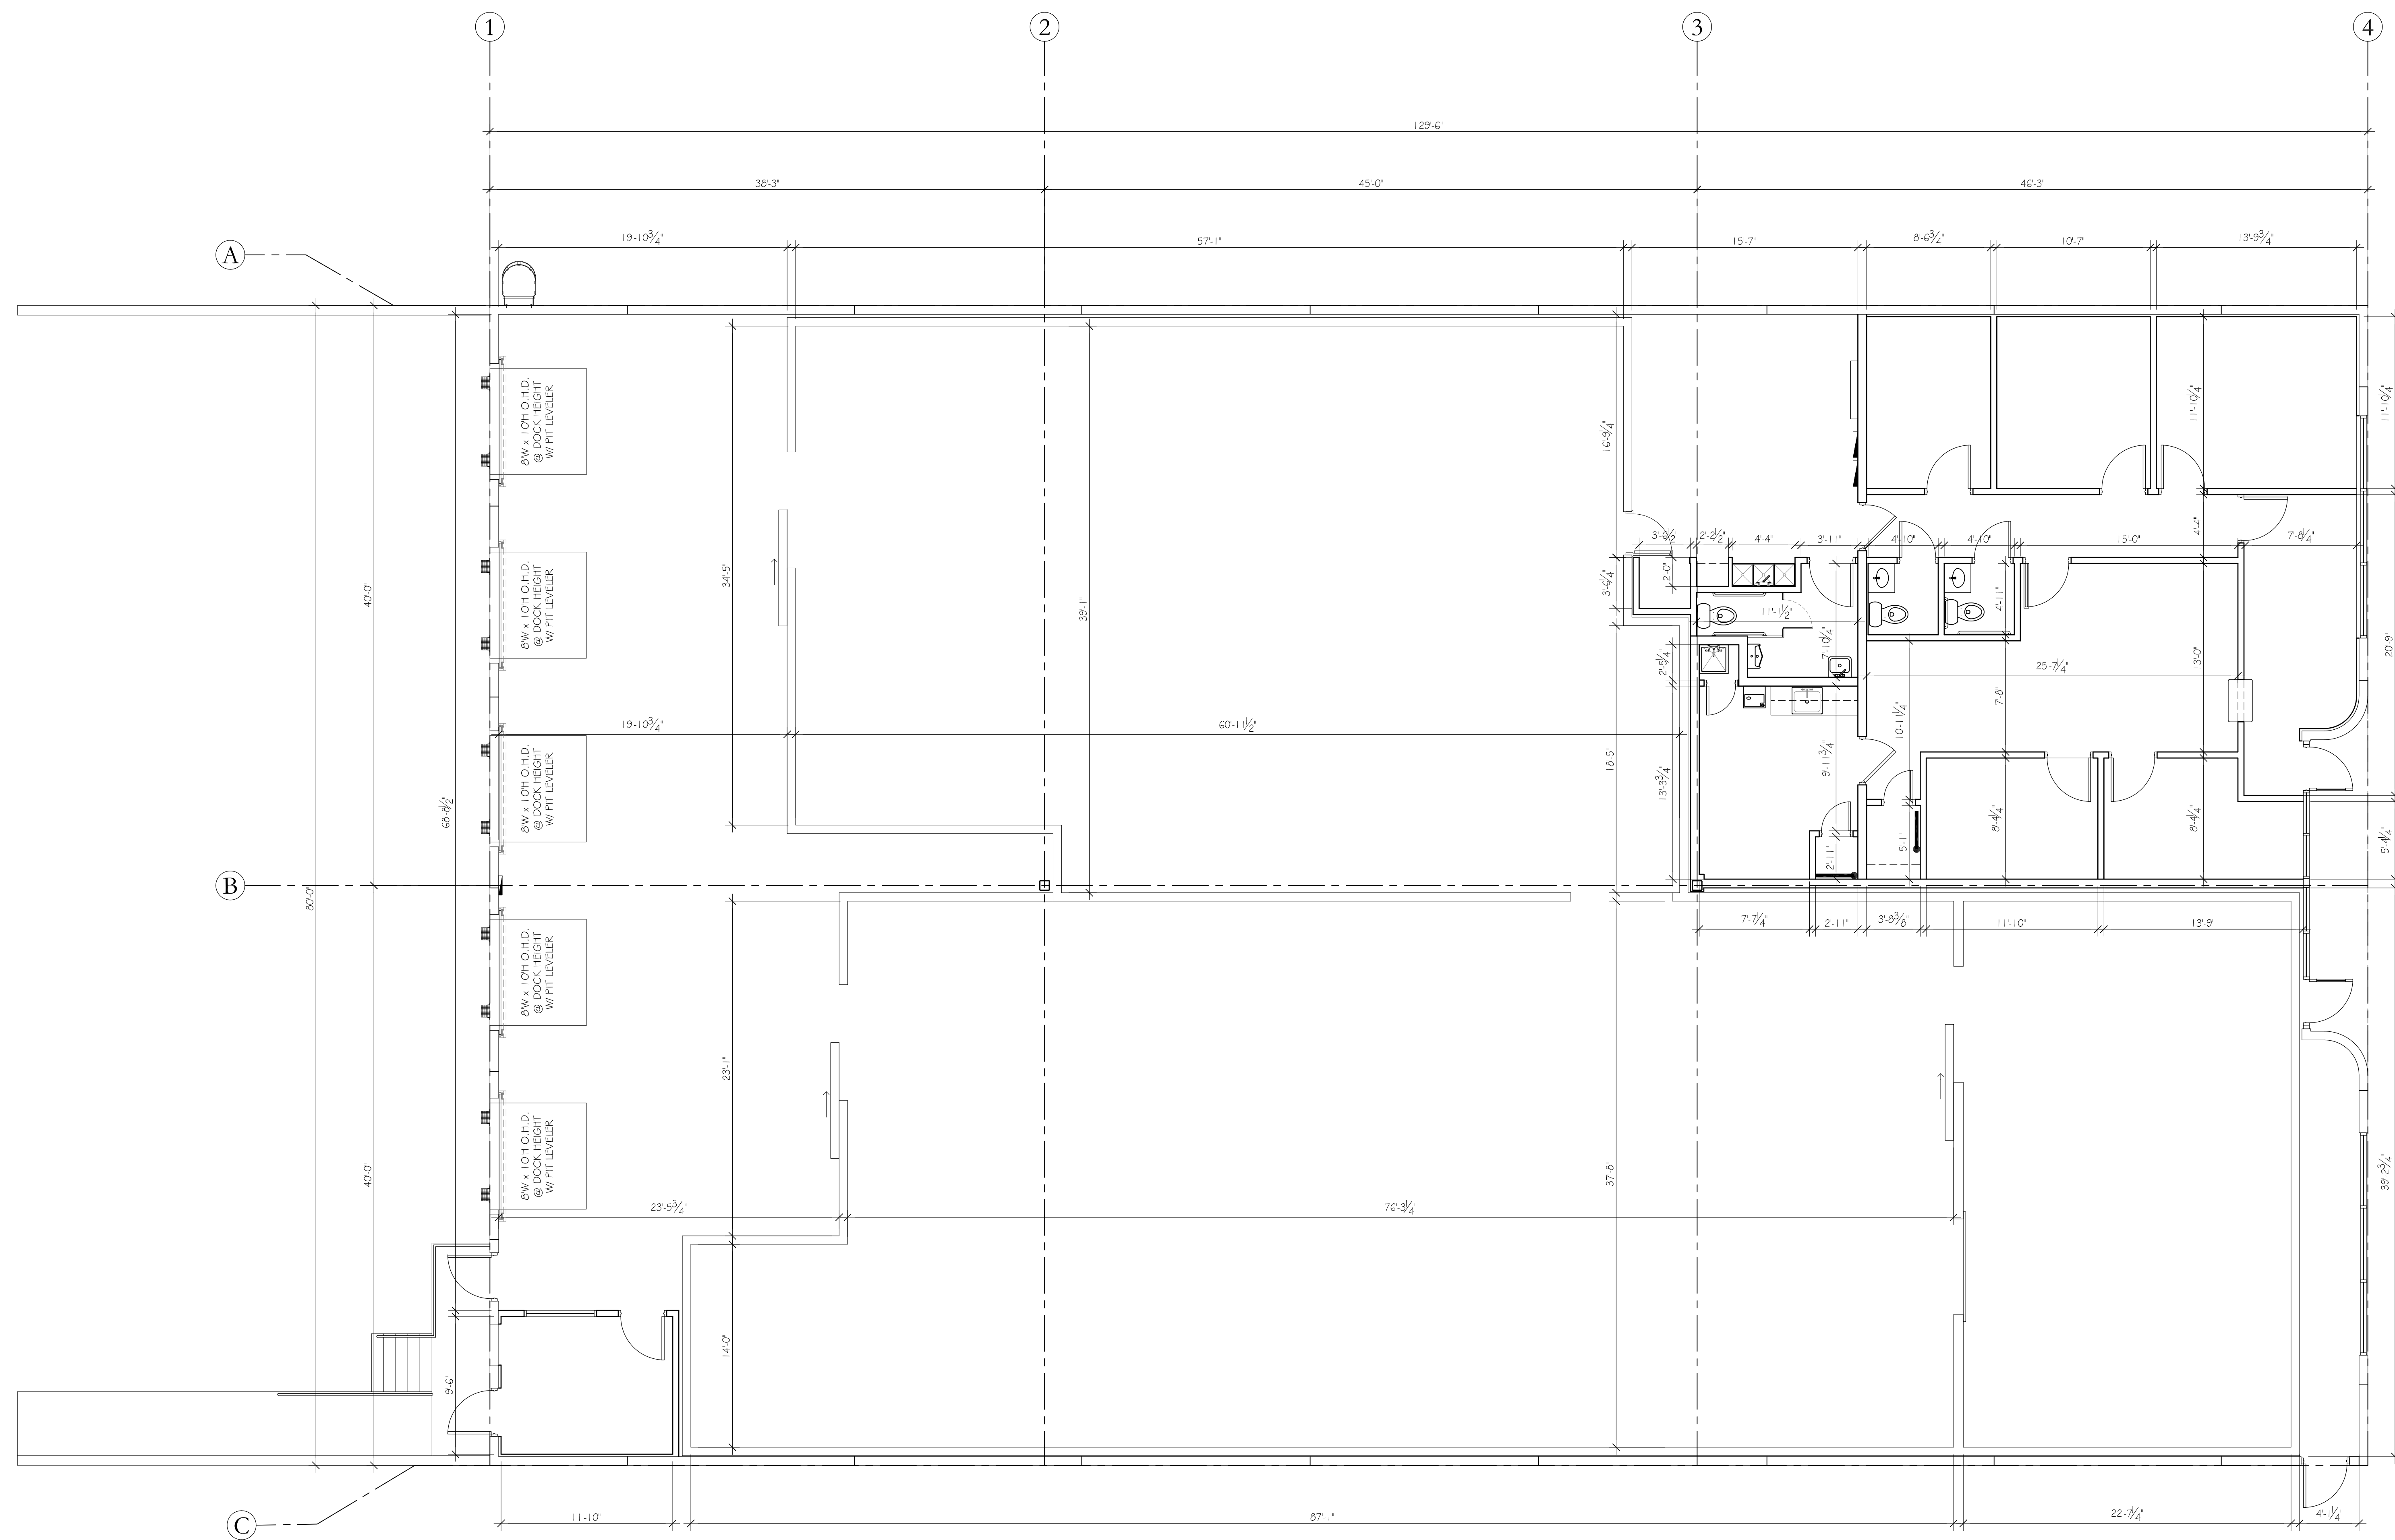

AREA CALCULATIONS


OFFICE=	1,348 SQ.FT.
WAREHOUSE=	8,929 SQ.FT.
COVERED AREA=	83 SQ.FT.
TOTAL=	10,360 SQ.FT.

AS-BUILTS

Existing Conditions

Prepared for Link
 5330 NW 35th Ave,
 Fort Lauderdale, FL 33309

ADAM RYDZEWSKI
 FLORIDA REGISTERED ARCHITECT
 REGISTRATION NO. AR0092163

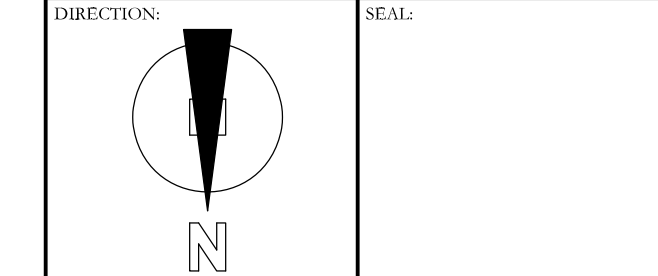

ISSUED DATE: 2025-08-13
 DRAWN BY: V.L.

DATE PRINTED: 2025-08-13
 CHECKED BY: A.R.

SCALE: AS NOTED
 PROJECT NO: 25-23

TITLE: EXISTING FLOOR PLAN - OVERALL

DRAWING NO: A-1.0