

THUNDERBIRD  
MEDICAL  
PLAZA I


# Floor 01

Suite 14A

AS-BUILT

1,716 SF

AVAILABLE

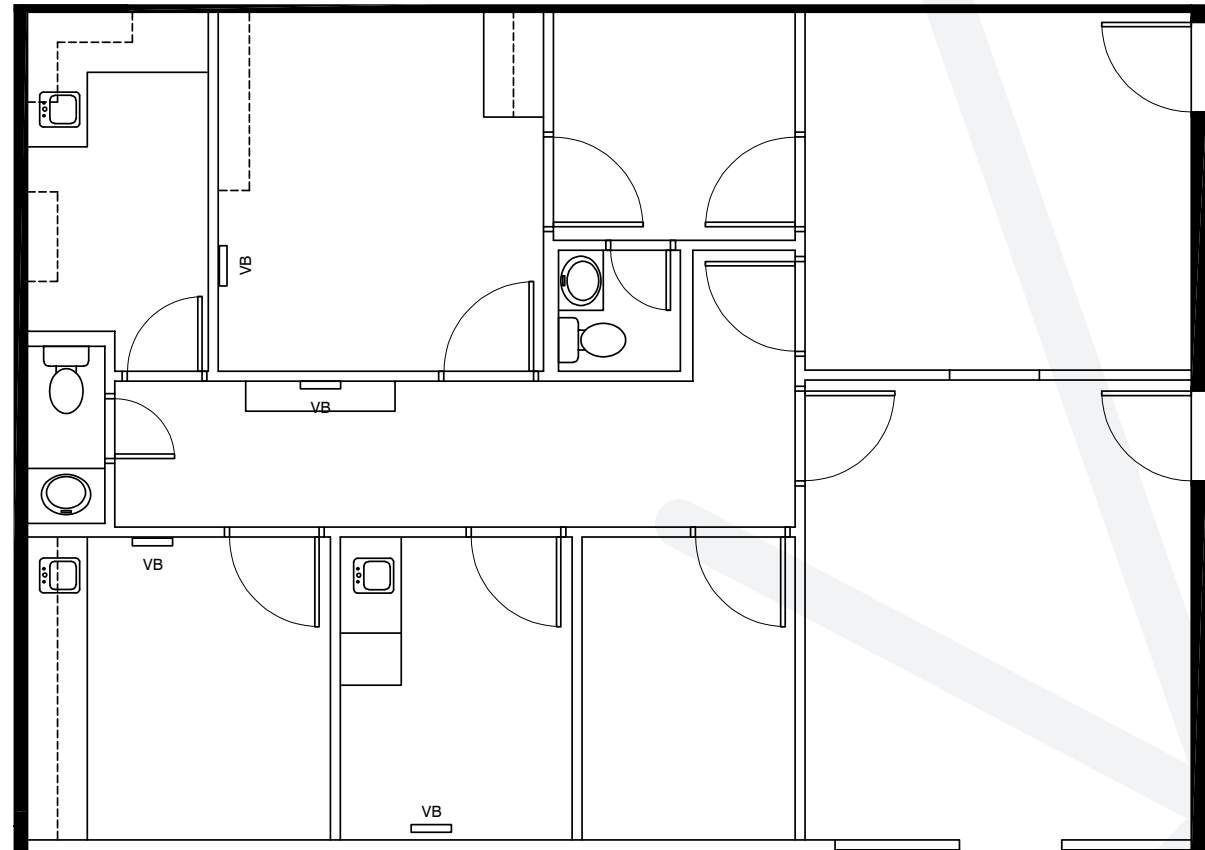

**RACHAEL THOMPSON**  
Senior Vice President  
602.513.5122  
rachael.thompson@kidder.com

**PERRY GABUZZI, CCIM**  
Executive Vice President  
602.513.5116  
perry.gabuzzi@kidder.com