


LAKEVIEW MEDICAL ARTS CENTER

Floor 1

Suite 50
AS-BUILT

2,887 SF
AVAILABLE

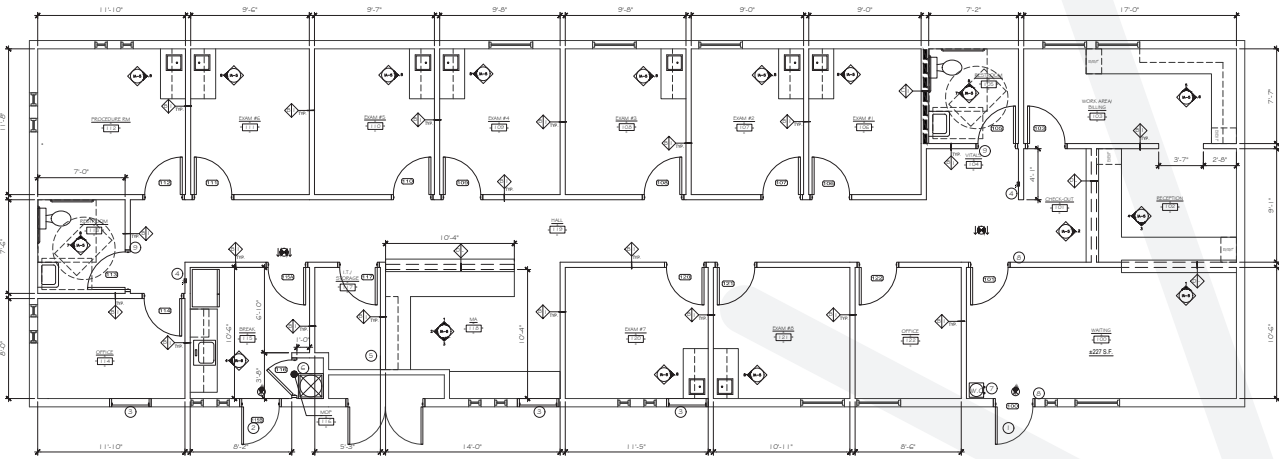

RACHAEL THOMPSON
Senior Vice President
602.513.5122
rachael.thompson@kidder.com

PERRY GABUZZI, CCIM
Senior Vice President
602.513.5116
perry.gabuzzi@kidder.com




LAKEVIEW MEDICAL ARTS CENTER

Floor 1

Suite 54
AS-BUILT

1,060 SF
AVAILABLE

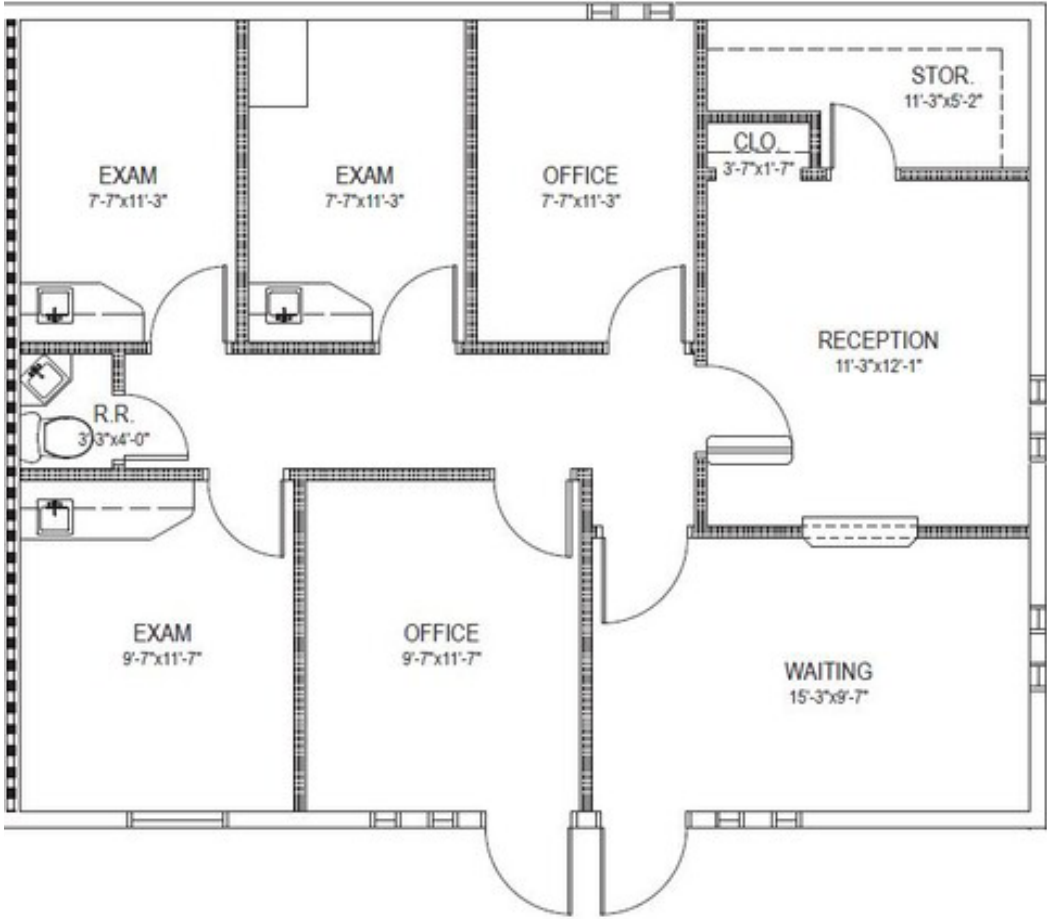

RACHAEL THOMPSON
Senior Vice President
602.513.5122
rachael.thompson@kidder.com

PERRY GABUZZI, CCIM
Senior Vice President
602.513.5116
perry.gabuzzi@kidder.com

**LAKEVIEW
MEDICAL
ARTS
CENTER**

13000 N 103RD AVE | SUN CITY, AZ 85351


Floor 1

Suite 59

AS-BUILT

1,121 SF

AVAILABLE

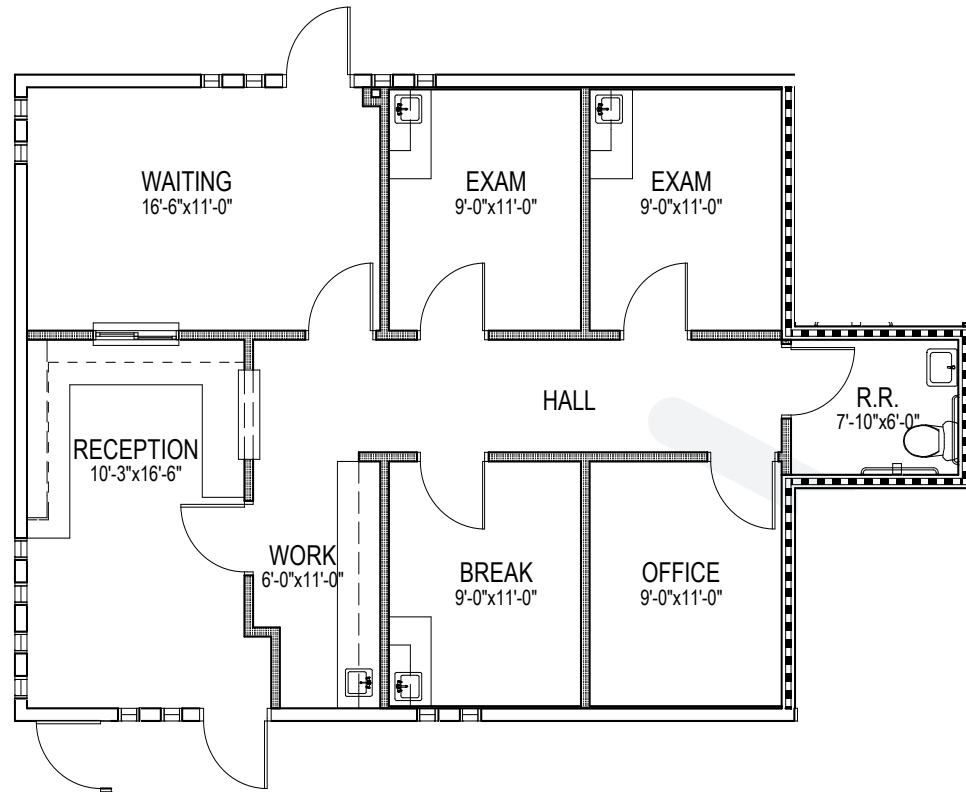

RACHAEL THOMPSON
Senior Vice President
602.513.5122
rachael.thompson@kidder.com


PERRY GABUZZI, CCIM
Senior Vice President
602.513.5116
perry.gabuzzi@kidder.com

**LAKEVIEW
MEDICAL
ARTS
CENTER**

Floor 1

Suite 61
AS-BUILT

1,408 SF
AVAILABLE

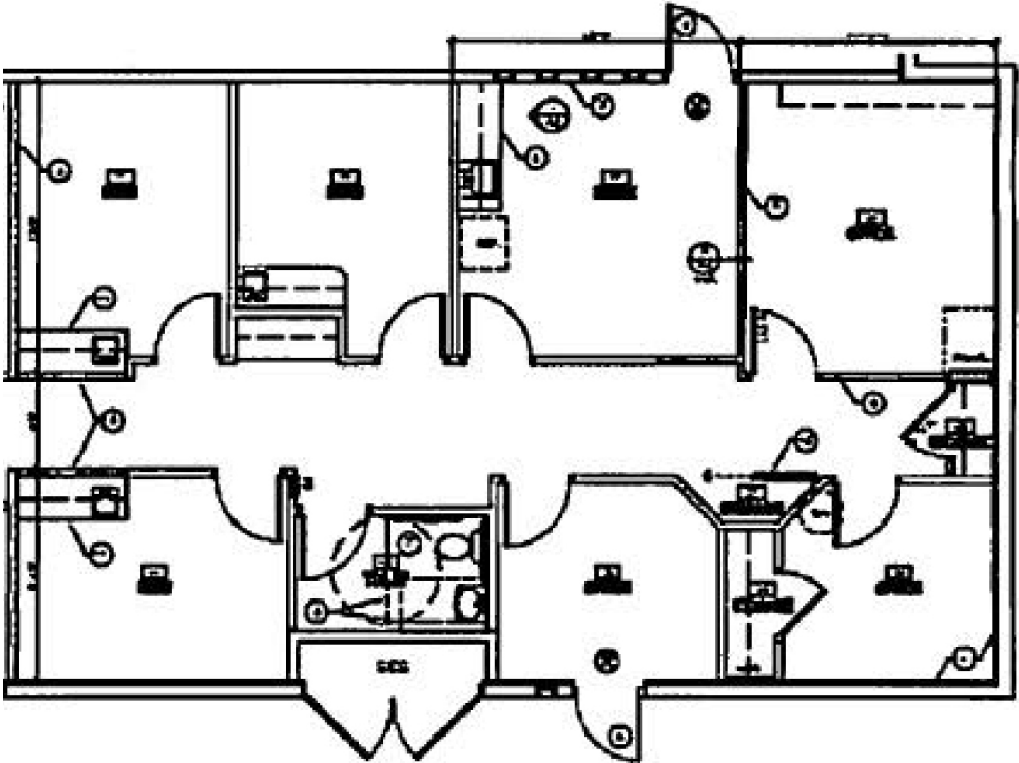

RACHAEL THOMPSON
Senior Vice President
602.513.5122
rachael.thompson@kidder.com


PERRY GABUZZI, CCIM
Senior Vice President
602.513.5116
perry.gabuzzi@kidder.com

LAKEVIEW MEDICAL ARTS CENTER

Floor 1

Suite 62
AS-BUILT

962 SF
AVAILABLE

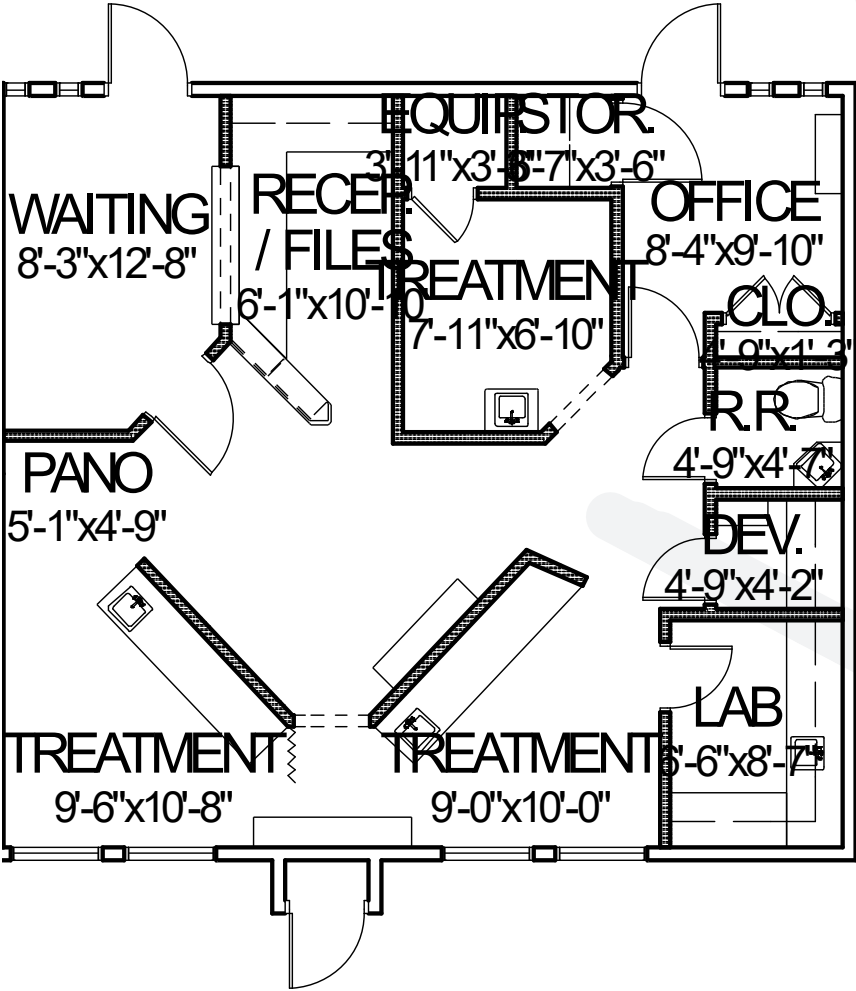

RACHAEL THOMPSON
Senior Vice President
602.513.5122
rachael.thompson@kidder.com


PERRY GABUZZI, CCIM
Senior Vice President
602.513.5116
perry.gabuzzi@kidder.com

LAKEVIEW MEDICAL ARTS CENTER

Floor 01

Suite 71
AS-BUILT

1,717 SF
AVAILABLE

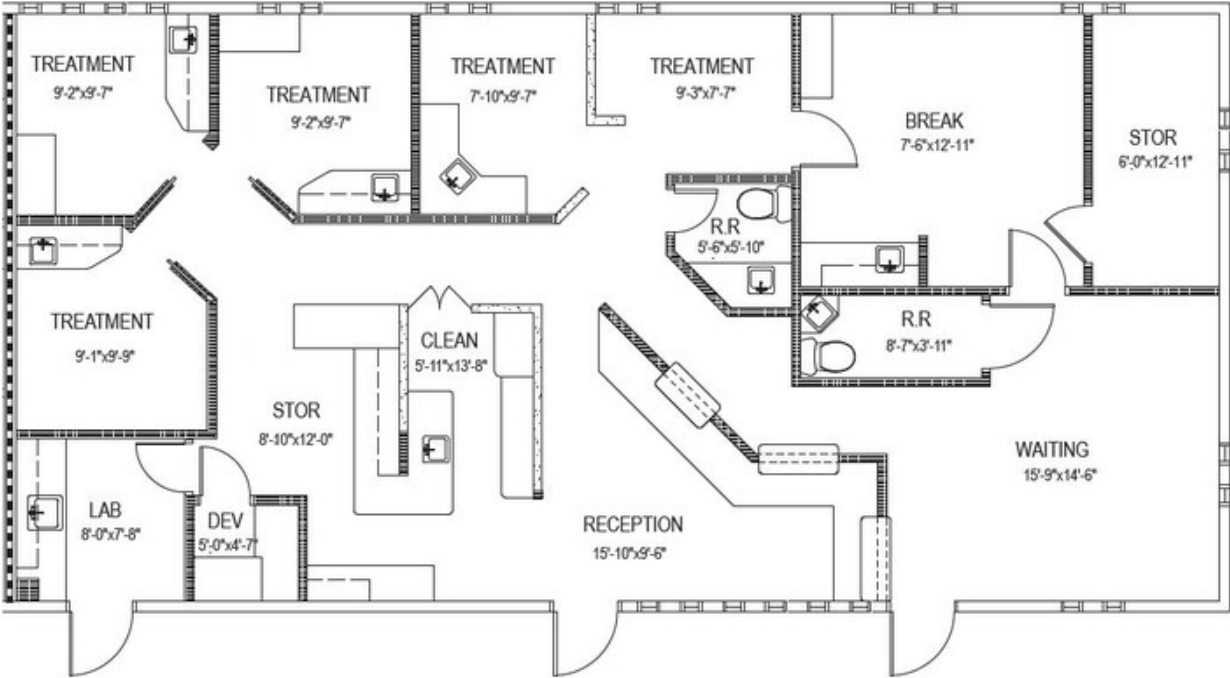

RACHAEL THOMPSON
Senior Vice President
602.513.5122
rachael.thompson@kidder.com


PERRY GABUZZI, CCIM
Senior Vice President
602.513.5116
perry.gabuzzi@kidder.com

LAKEVIEW MEDICAL ARTS CENTER

Floor 01

Suite 74
AS-BUILT

1,119 SF
AVAILABLE

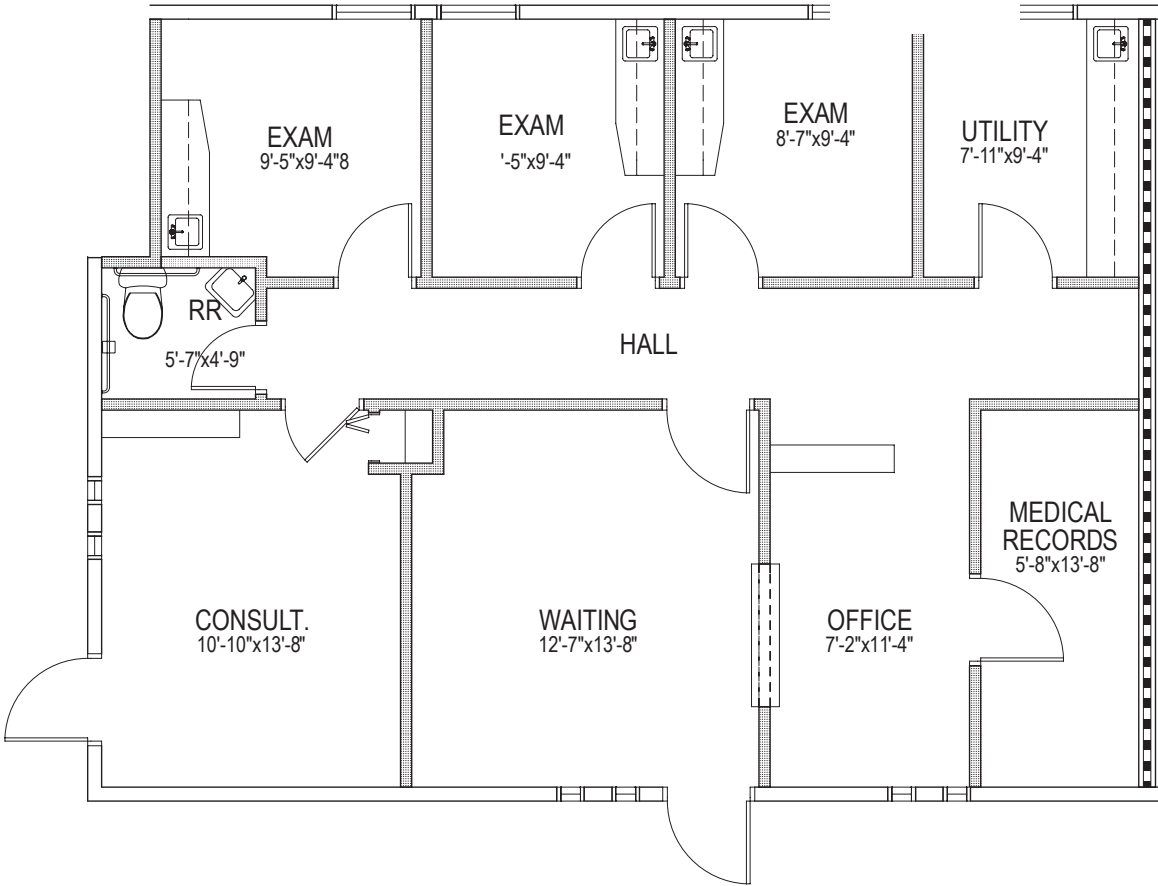

RACHAEL THOMPSON
Senior Vice President
602.513.5122
rachael.thompson@kidder.com


PERRY GABUZZI, CCIM
Senior Vice President
602.513.5116
perry.gabuzzi@kidder.com

LAKEVIEW MEDICAL ARTS CENTER

Floor 01

Suite 76
AS-BUILT

1,479 SF
AVAILABLE

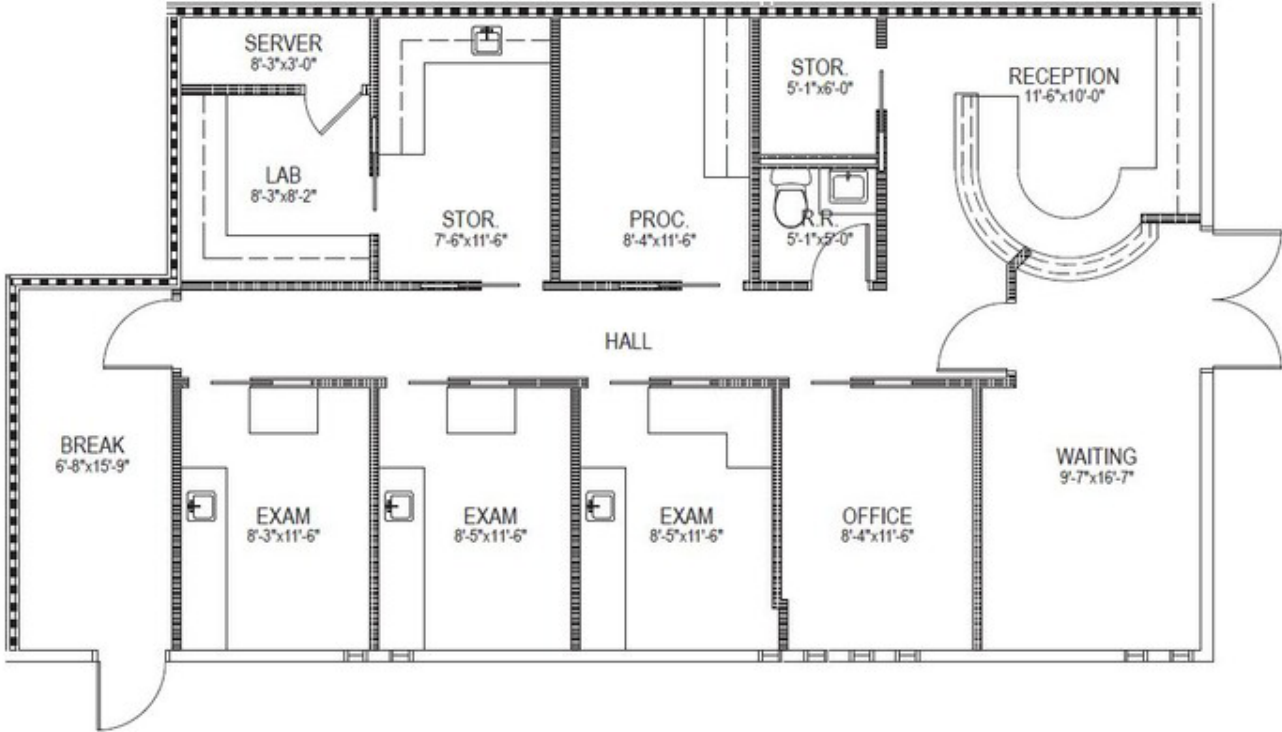

RACHAEL THOMPSON
Senior Vice President
602.513.5122
rachael.thompson@kidder.com


PERRY GABUZZI, CCIM
Senior Vice President
602.513.5116
perry.gabuzzi@kidder.com

LAKEVIEW MEDICAL ARTS CENTER

Floor 01

Suite 77
AS-BUILT

1,433 SF
AVAILABLE

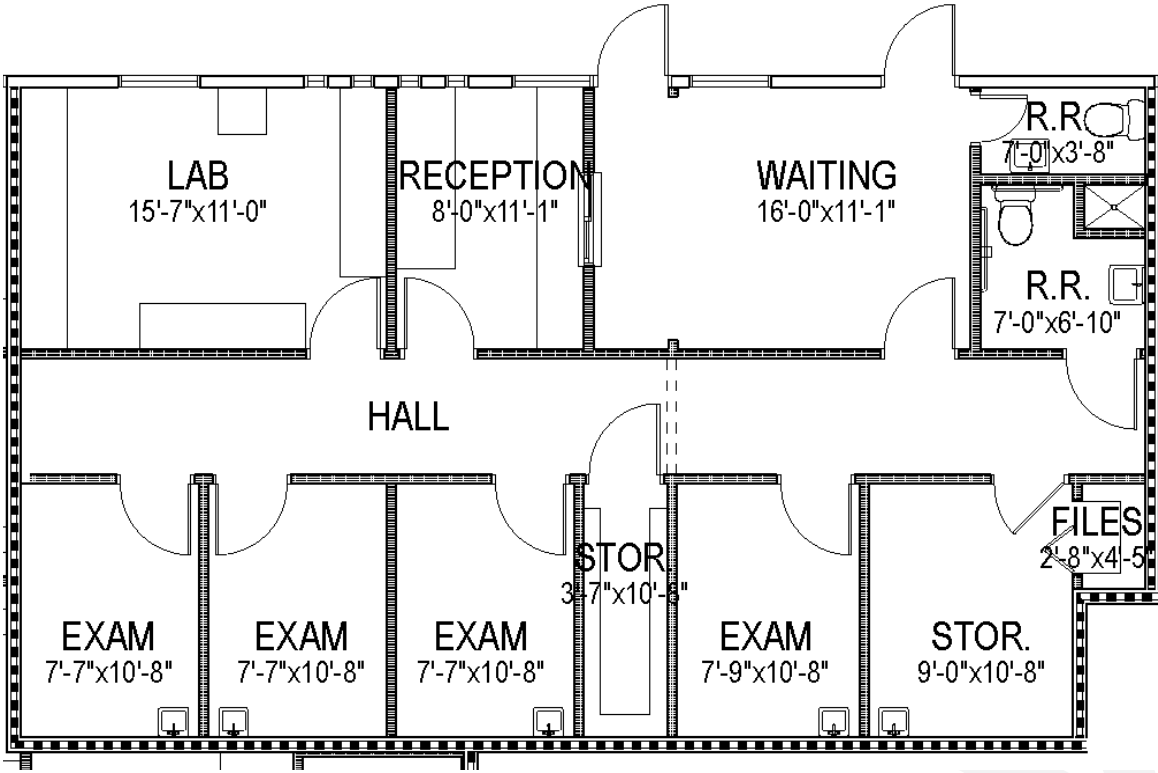

RACHAEL THOMPSON
Senior Vice President
602.513.5122
rachael.thompson@kidder.com

PERRY GABUZZI, CCIM
Senior Vice President
602.513.5116
perry.gabuzzi@kidder.com

**LAKEVIEW
MEDICAL
ARTS
CENTER**

13000 N 103RD AVE | SUN CITY, AZ 85351


Floor 01

Suite 97

AS-BUILT

2,996 SF

AVAILABLE

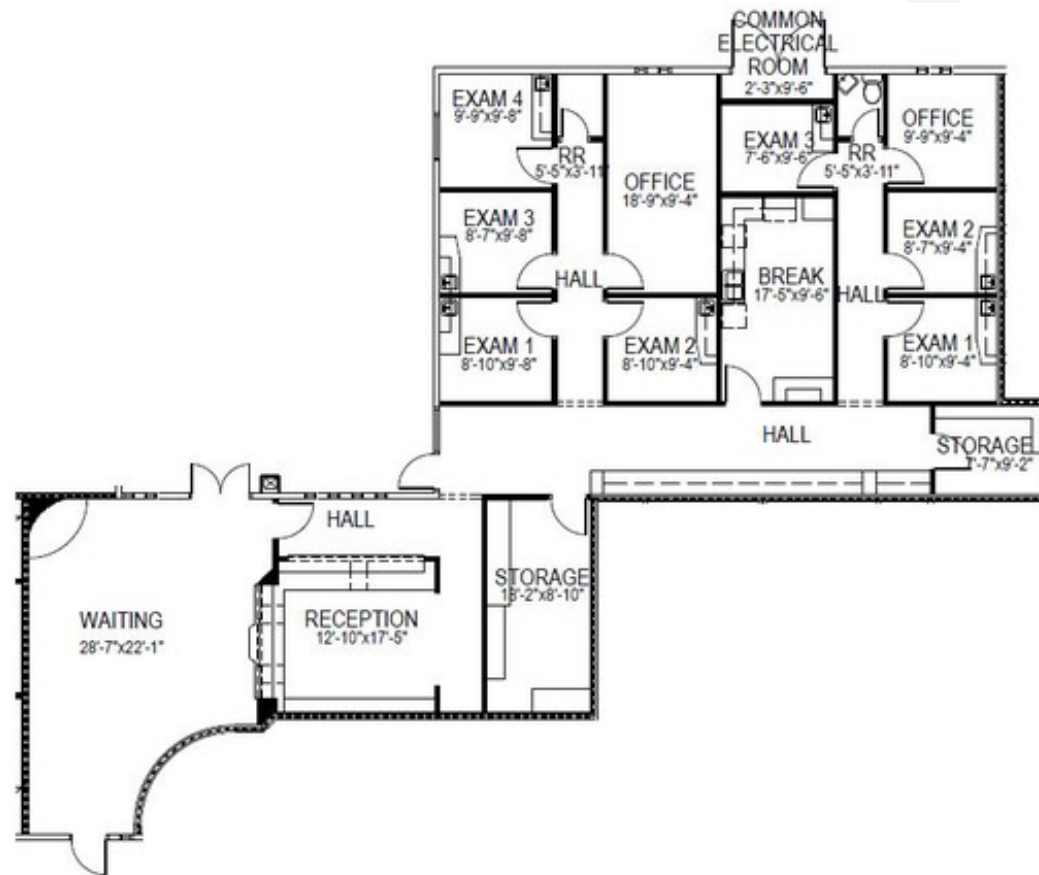

RACHAEL THOMPSON
Senior Vice President
602.513.5122
rachael.thompson@kidder.com

PERRY GABUZZI, CCIM
Senior Vice President
602.513.5116
perry.gabuzzi@kidder.com