



85 N MAIN ST. MT CLEMENS, MI 48043  
1ST FLOOR - AS-BUILT FLOOR PLAN  
SCALE: 1/8" = 1'-0"  
5/24/2022  
NORTH

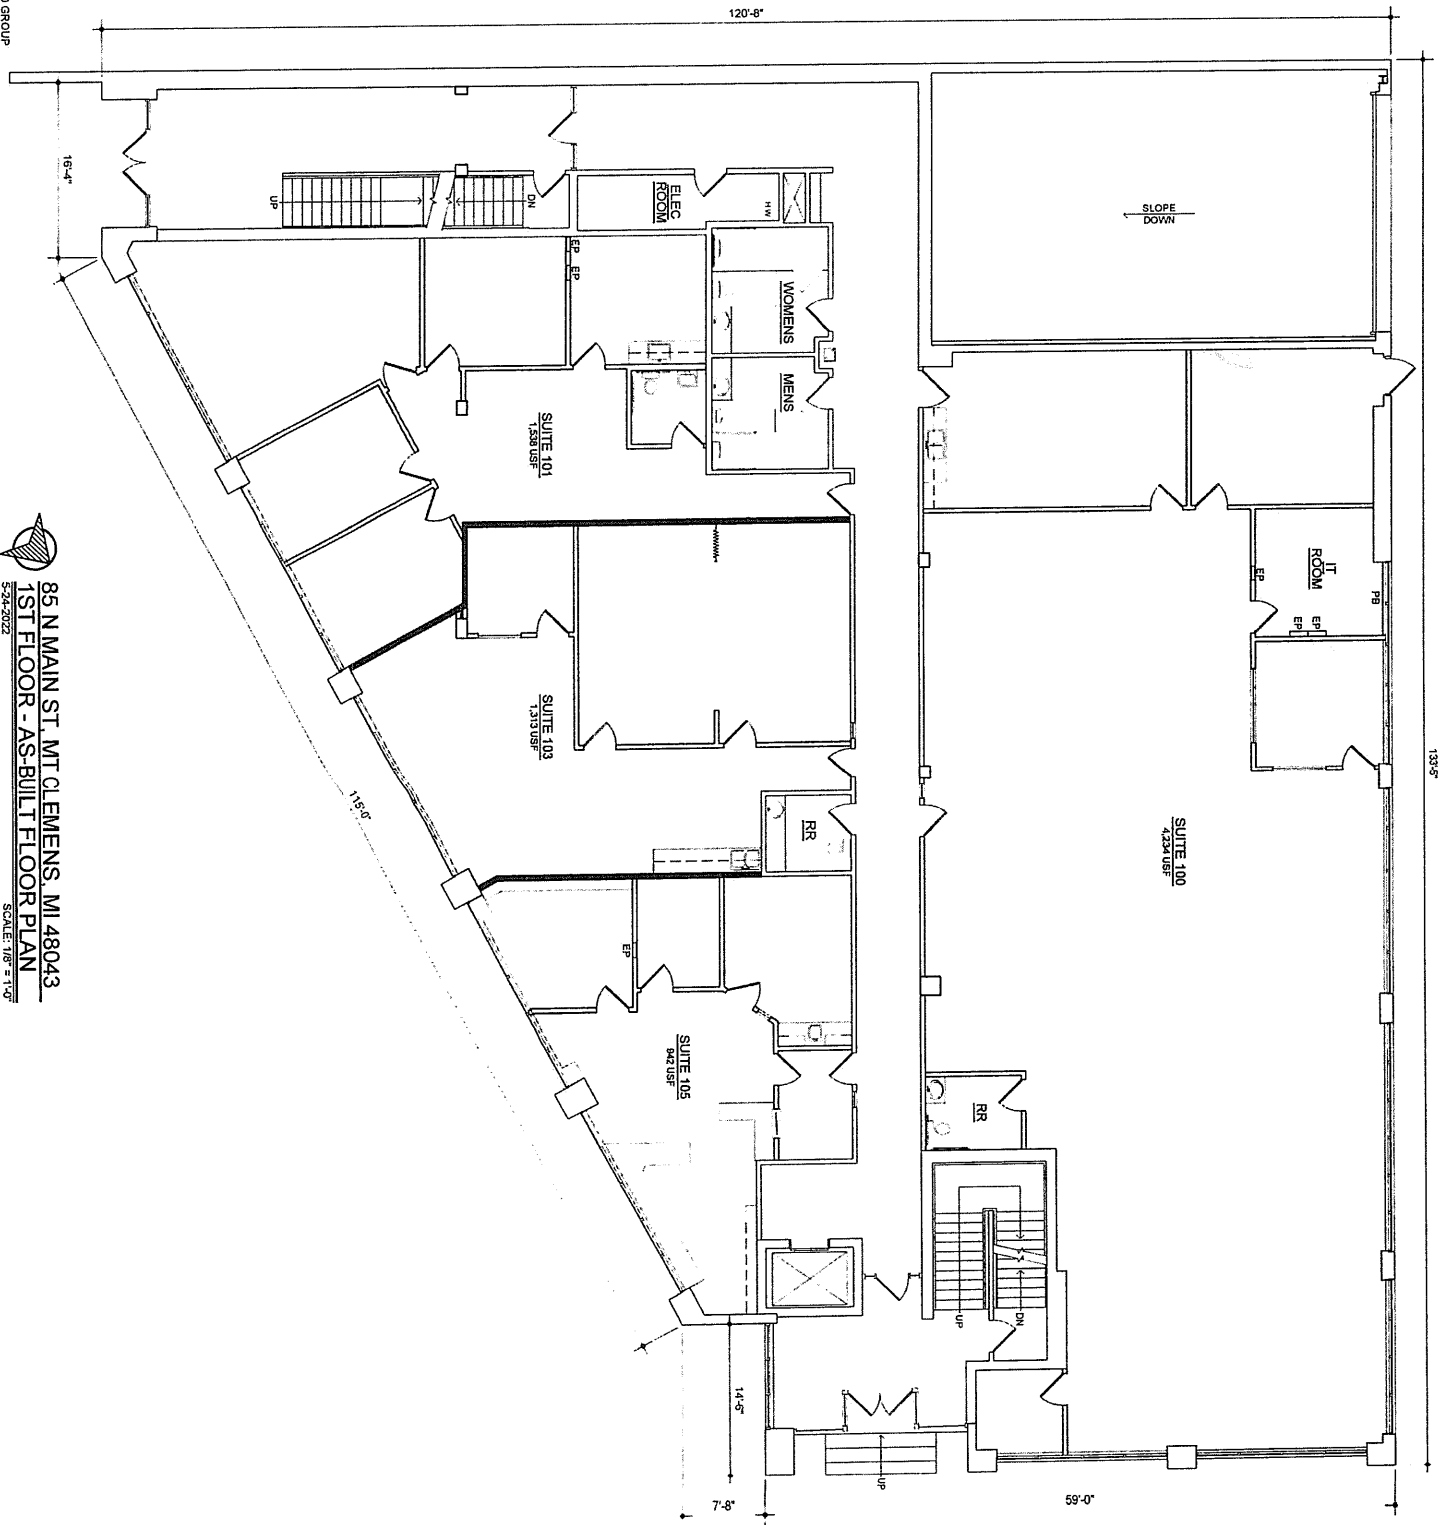

85 N MAIN ST. MT CLEMENS, MI 48043  
2ND FLOOR - AS-BUILT FLOOR PLAN  
5/24/2022  
SCALE: 1/8" = 1'-0"  
NORTH

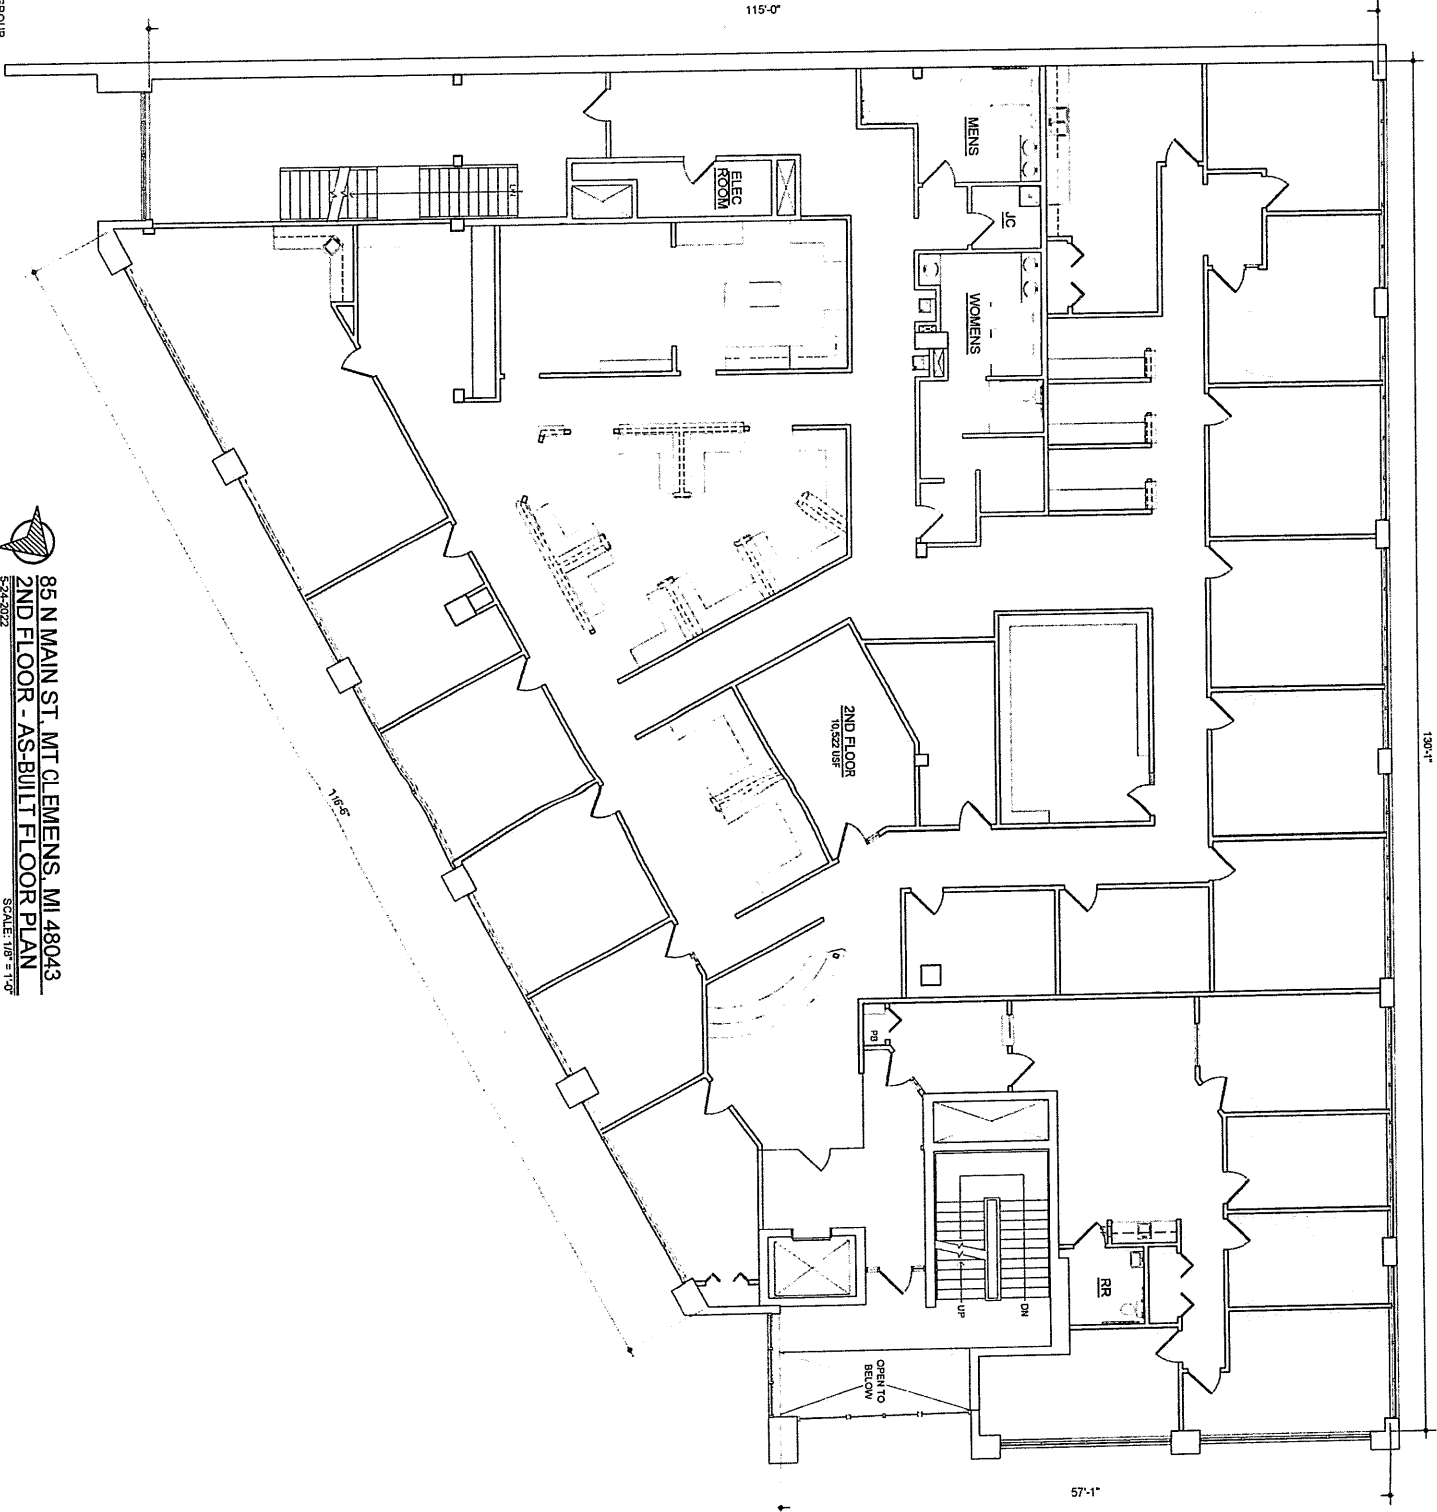

115'-0"

57'-1"

130'-1"

PREPARED BY METRO CAD GROUP

85 N MAIN ST. MT. CLEMENS, MI 48043  
3RD FLOOR - AS-BUILT FLOOR PLAN  
5-24-2022  
SCALE: 1/8" = 1'-0"

