



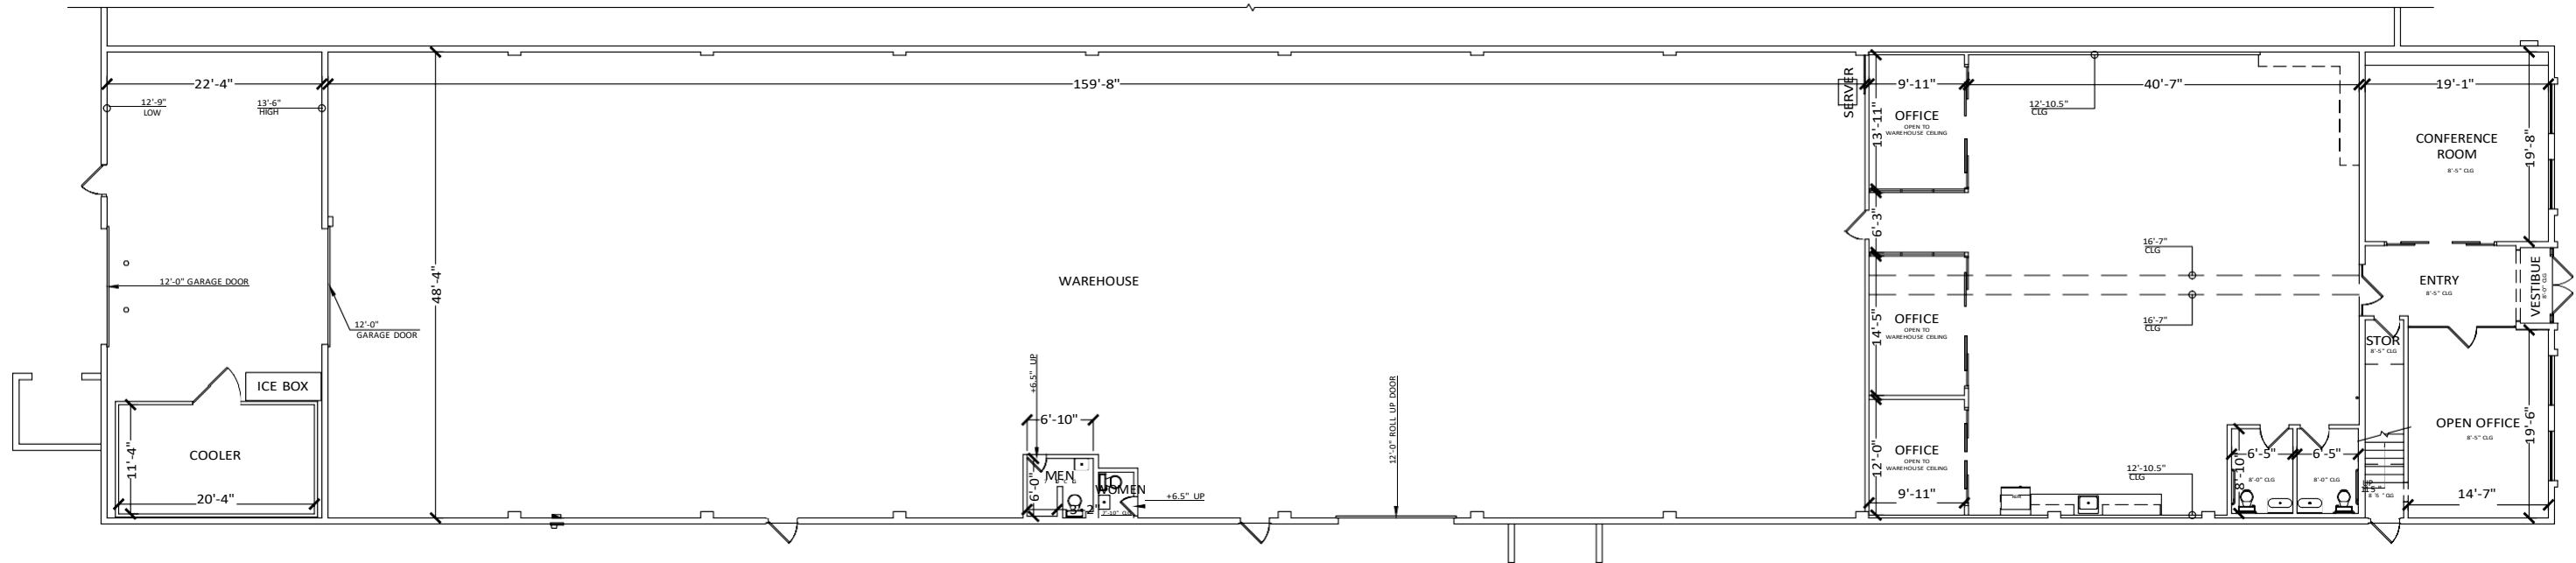

1ST FLOOR

Please Note: Square footages reflect measurement of inside wall to inside wall

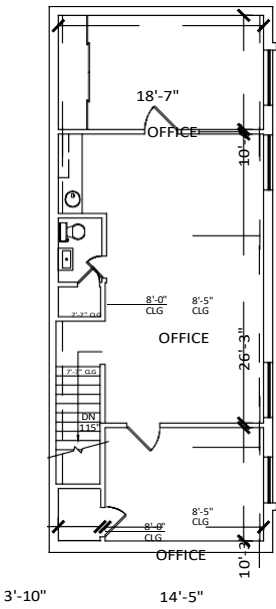

2ND FLOOR



CLG = CEILING HEIGHT



PRECISION PROPERTY
MEASUREMENTS

3626 E. PACIFIC COAST
HIGHWAY | 2ND FLOOR
LONG BEACH CA | 90804
T 562.621.9100
F 888.698.2966
WWW.PPMCO.NET



PREPARED FOR

RICHARD ALTUNA

PROJECT TYPE

FLOOR PLAN


PROJECT NAME

JEFFERSON
BOULEVARD
PROJECT

PROJECT ADDRESS

10459 JEFFERSON
BOULEVARD
CULVER CITY, CA 90232

All plans created by Precision Property Measurements use "TRUE" are made exclusively for indicating purposes (Cal. Bus. & Prof. Code 8672). All site plans created by PPM do not involve the determination of any property line, and as such do not constitute land surveys. (Cal. Bus. & Prof. Code 8687.1 & 8687.2). In addition, PPM services are not to be used to constitute engineering (Cal. Bus. & Prof. Code 8630 & 8631), and thus should not be used for any studies or activities defined as engineering (Cal. Bus. & Prof. Code 8632). All floor plans created by PPM are intended to be used as a reference for design and construction and should not be considered a substitute for the services of a licensed structural engineer or licensed architect. PPM makes every reasonable effort to ensure the accuracy of its information based on the plans, however, errors do exist. Drawing inherently contains errors to some degree. It is the duty of the architect, contractor, designer or other licensed professional, as a consultant to the property owner, to determine the suitability of the to-build plans prior to construction. Measurements should be field confirmed before commencing construction. In the event that an error is found on a plan, PPM's liability is limited to the amount of the fee paid to PPM.

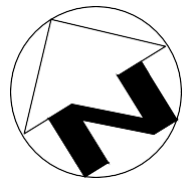

SCALE
1/4" = 1'-0"

PROJECT
16809

APPROVED BY
RR

DATE
08/07/18

SHEET

1 of 1

