


SUITE 285  
AS BUILT - 1 OF 1  
8514 MCALPINE PARK DRIVE  
VERIFY RSF  
SCALE: 1/8" = 1'-0"  
DATE: SEPTEMBER 11, 2025

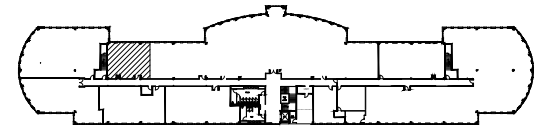

KEY PLAN

