



Exhibit "A" - Premises



W. ASHBY PLACE

FREDERICKSBURG ROAD

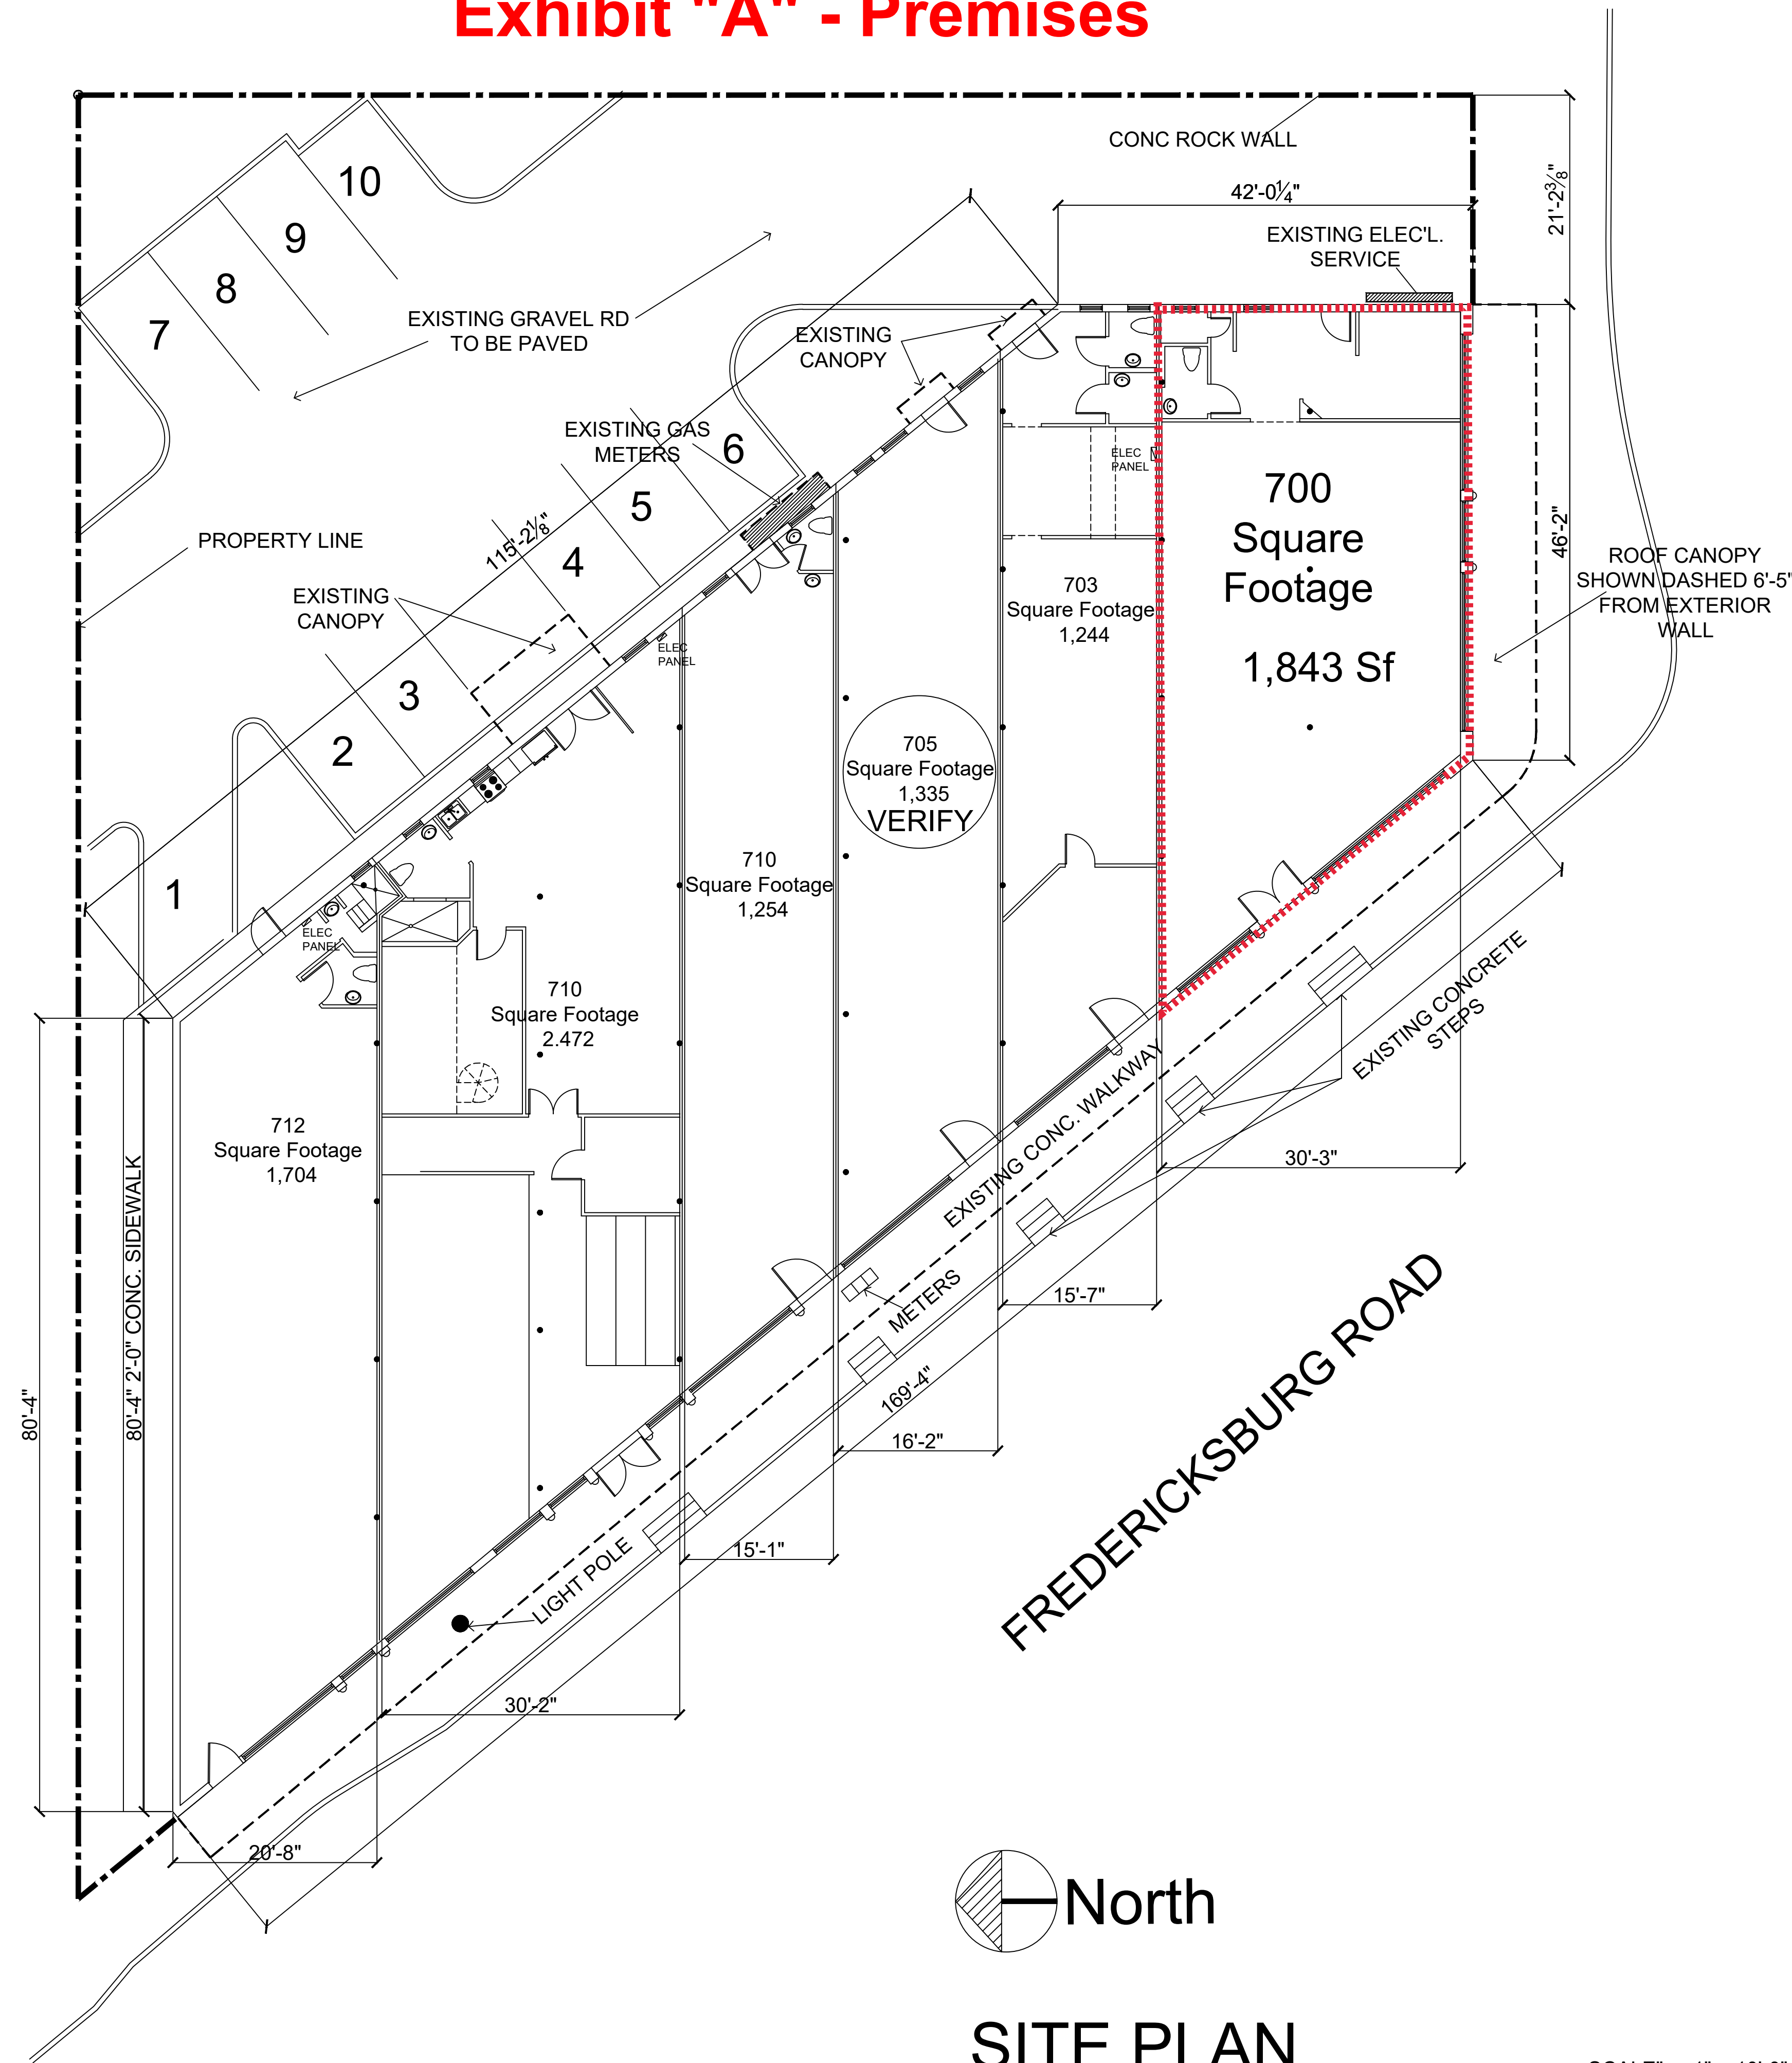

MARK
DESIGN BUILD

CONSULTANT:

COPYRIGHT:

PROJECT NAME:
AS BUILT FLOOR PLAN

PROJECT LOCATION:
708 Fredericksburg Rd.
San Antonio, Texas

PROJECT OWNER:
CENTRO PROPERTIES
collin@centroproperties.net

REVISIONS:	
	▲


ISSUE DATE:	09/11/23
PROJECT NOS.	2302
CAD DWG FILE:	
DRAWN BY:	M.G.
CHECKED BY:	A.G.
SCALE:	AS NOTED

SHEET TITLE:
SITE PLAN / FLOOR PLAN
AT
FREDERICKSBURG
RETAIL STORE

SHEET NO.:

A01

OF:

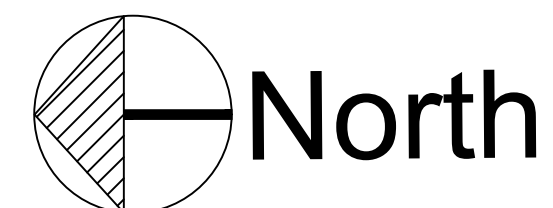

SITE PLAN

SCALE" = 1" = 10'-0"