


10150 SOUTH HIGHWAY 6 AS-BUILT
1,300 N.R.A.

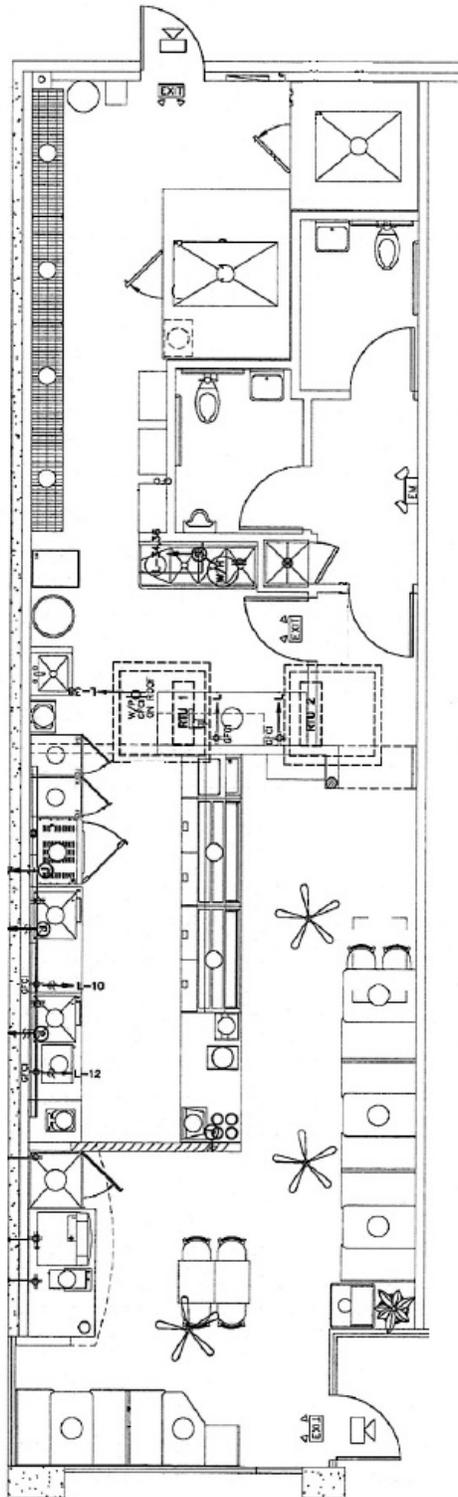

WOODBIDGE CENTER 3-23-26
ALL MEASUREMENTS ARE APPROXIMATE