



Suite 505

4,231 RSF

As-Built

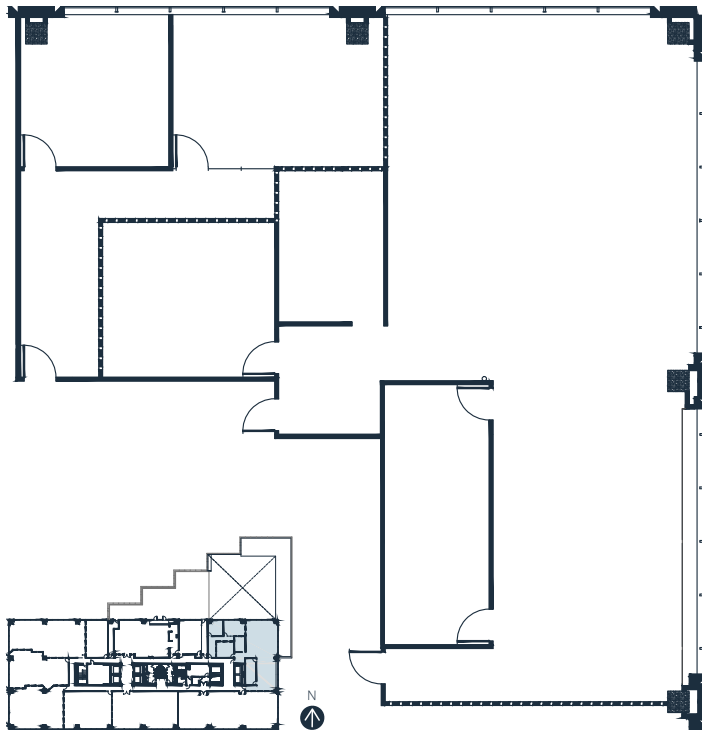

Hypothetical

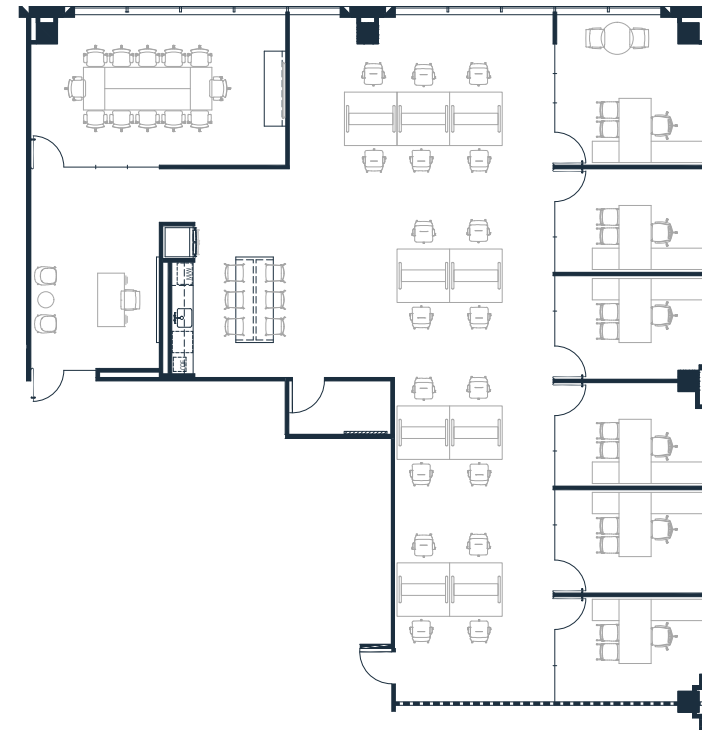

Addie Ludwig

aludwig@coheracommercial.com

Parker Bowlin

pbowlin@coheracommercial.com

Kristi Waddell

kwaddell@coheracommercial.com



Download Floorplan 