
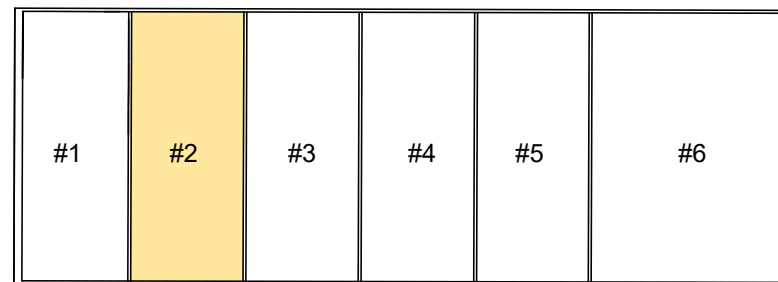


DETAIL A
 Scale 1:50

UNIT #2

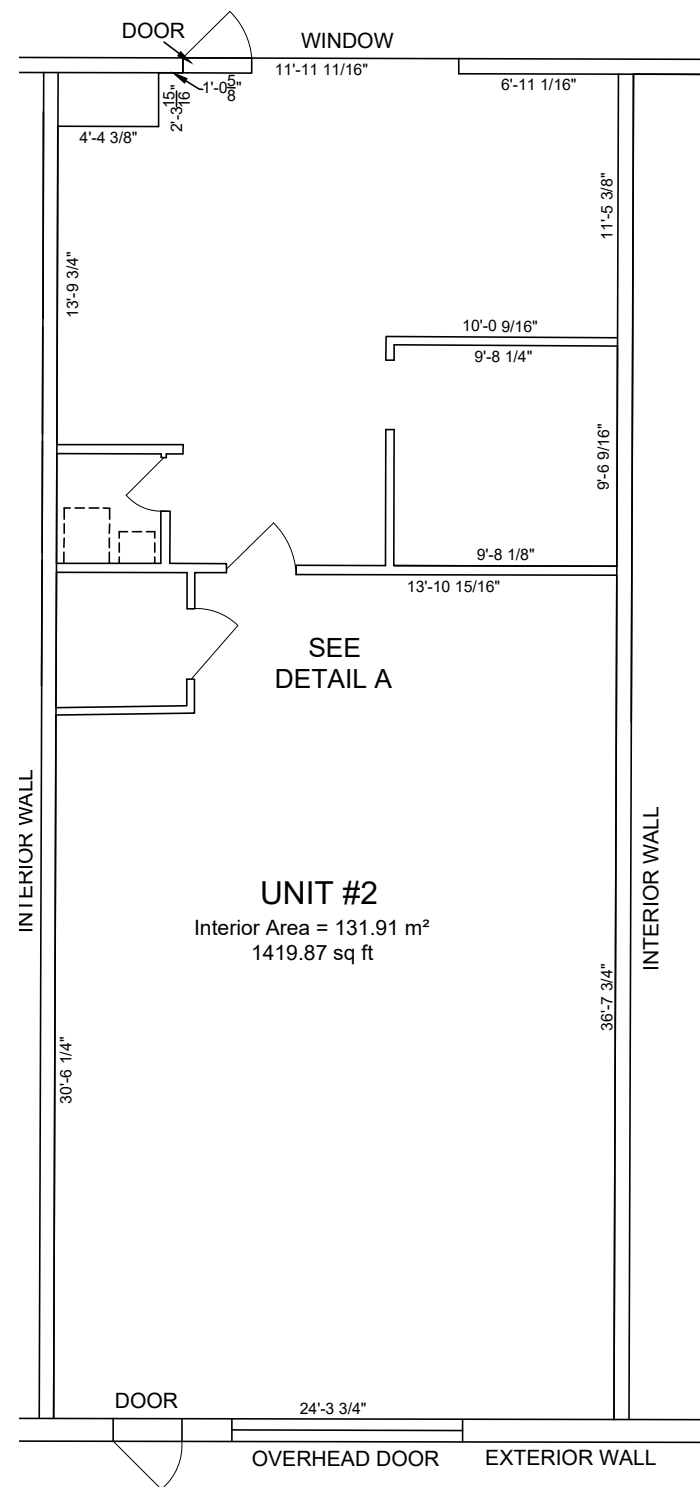

Key Plan
 Scale 1:500

As-Built Plan

Unit 2
 1247 - 36th AVENUE NE
 CALGARY, ALBERTA


Client

VG GROUP HOLDING INC.
 1247 - 36th AVENUE NE
 CALGARY, ALBERTA
 T2E 6N6



GLOBAL RAYMAC SURVEYS INC.

Suite 110, 4129 - 8th Street SE, Calgary, Alberta T2G 3A5
 Ph: 403.283.5455 www.globalraymac.ca

Date: 14 January 2025	Scale: 1:100
Drawn By: EB	Checked By: CL
File Number: 24CX0051-UNIT2	Revision
	Sheet
0	1 of 1

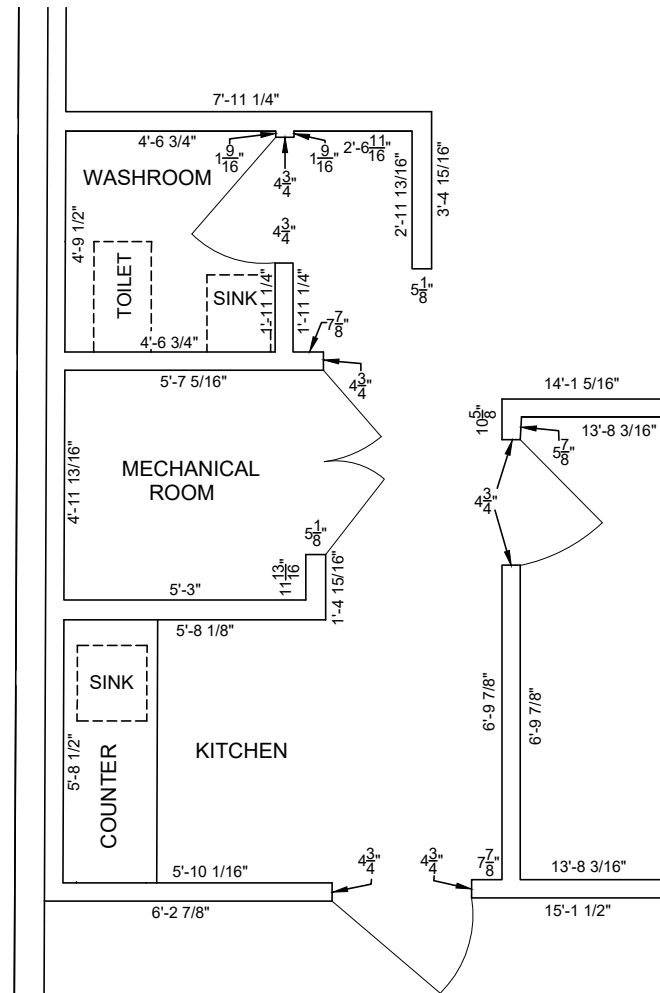

DETAIL A
Scale 1:50

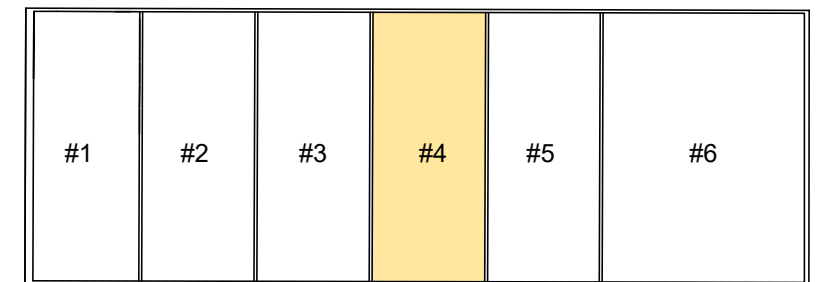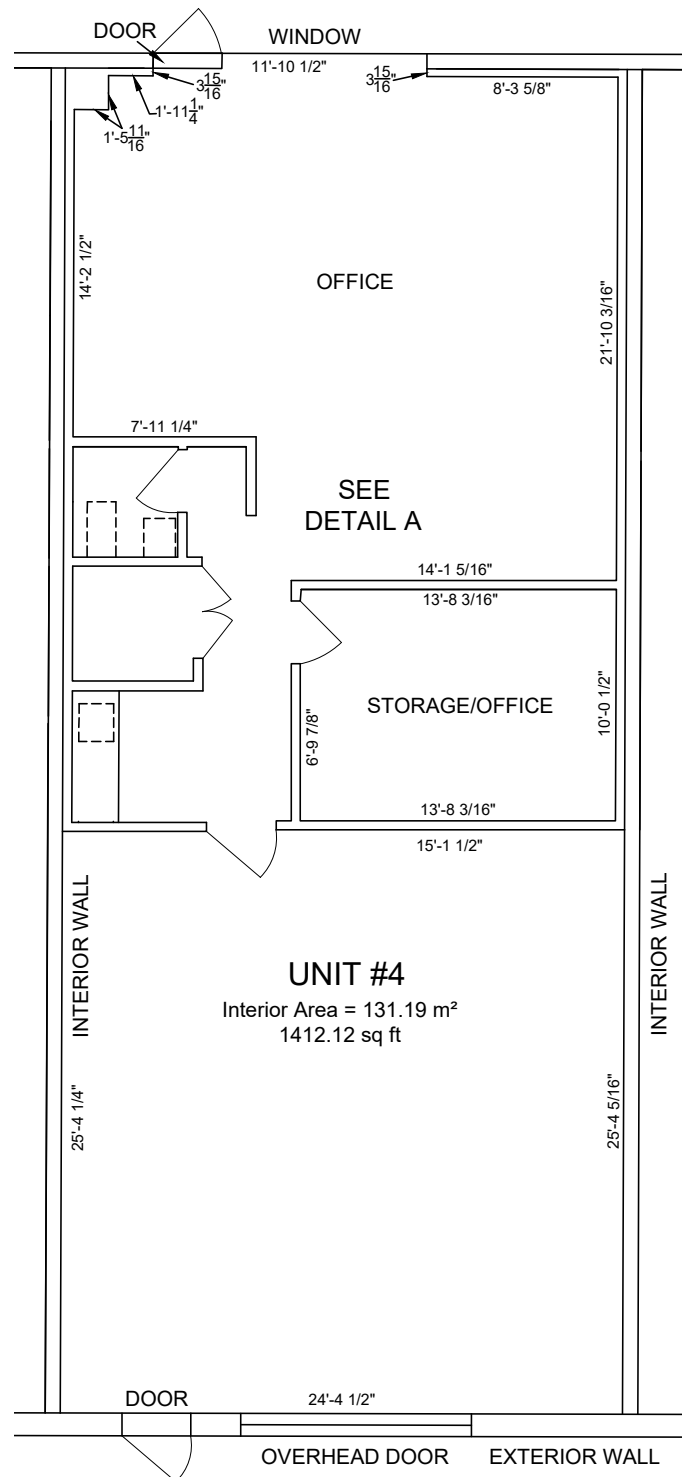

Key Plan
Scale 1:500

As-Built Plan

Unit 4
1247 - 36th AVENUE NE
CALGARY, ALBERTA


Client

VG GROUP HOLDING INC.
1247 - 36th AVENUE NE.
CALGARY, ALBERTA
T2E 6N6


GLOBAL RAYMAC SURVEYS INC.

Suite 110, 4129 - 8th Street SE, Calgary, Alberta T2G 3A5
Ph: 403.283.5455 www.globalraymac.ca


Date: 14 January 2025	Scale: 1:100
Drawn By: EB	Checked By: CL
File Number: 24CX0051-UNIT4	Revision
	Sheet
0	1 of 1

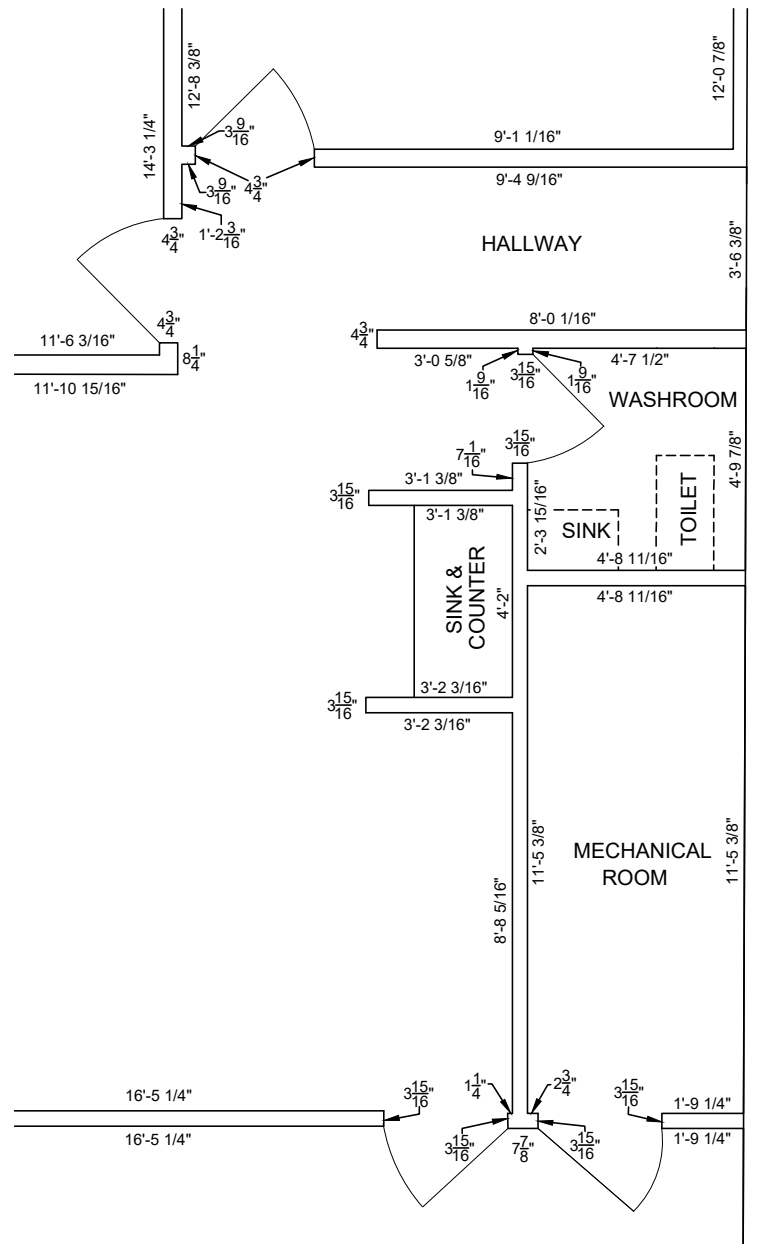

DETAIL A
Scale 1:50

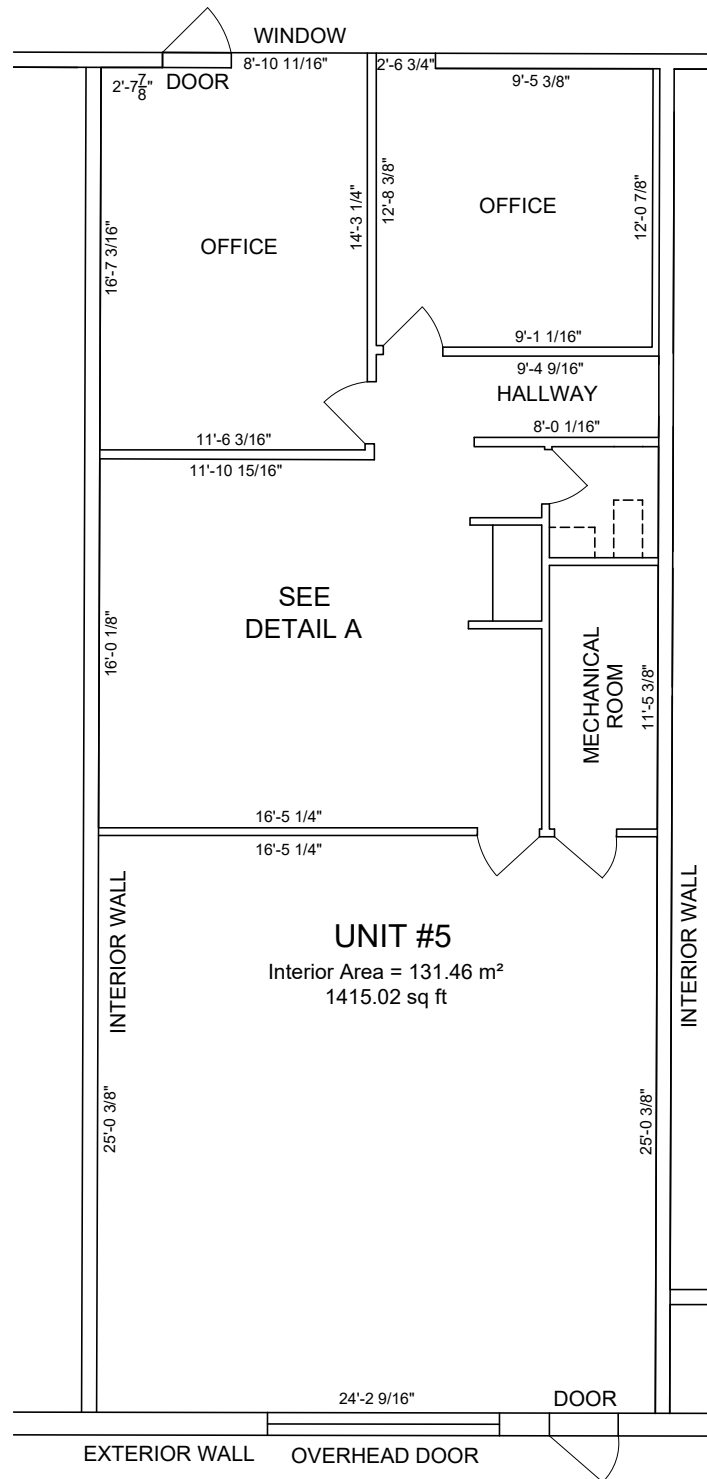

UNIT #5
Interior Area = 131.46 m²
1415.02 sq ft

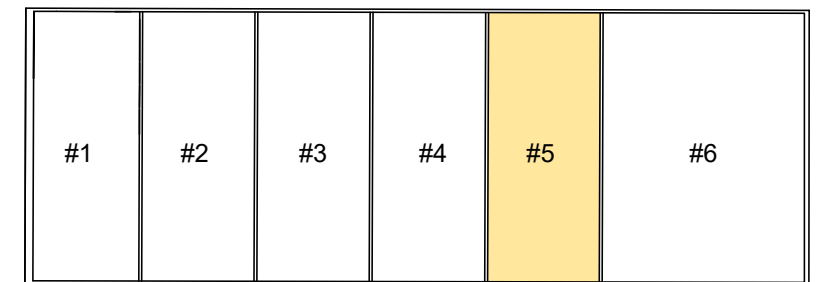

Key Plan
Scale 1:500

As-Built Plan

Unit 5
1247 - 36th AVENUE NE
CALGARY, ALBERTA

Client

VG GROUP HOLDING INC.
1247 - 36th AVENUE NE.
CALGARY, ALBERTA
T2E 6N6

GLOBAL RAYMAC SURVEYS INC.

Suite 110, 4129 - 8th Street SE, Calgary, Alberta T2G 3A5
Ph: 403.283.5455 www.globalraymac.ca

Date: 14 January 2025	Scale: 1:100
Drawn By: EB	Checked By: CL
File Number: 24CX0051-UNIT5	Revision
	Sheet
0	1 of 1

