

INDUSTRIAL SPACE FOR LEASE

ASKING \$12.75 PSF NNN
OFFERING A \$1.00 PSF MOVING ALLOWANCE

4761 Hugh Howell Road
Suite D | Tucker, GA 30084



FOR LEASE


±4,800 SF

SUITE D




LEASED BY



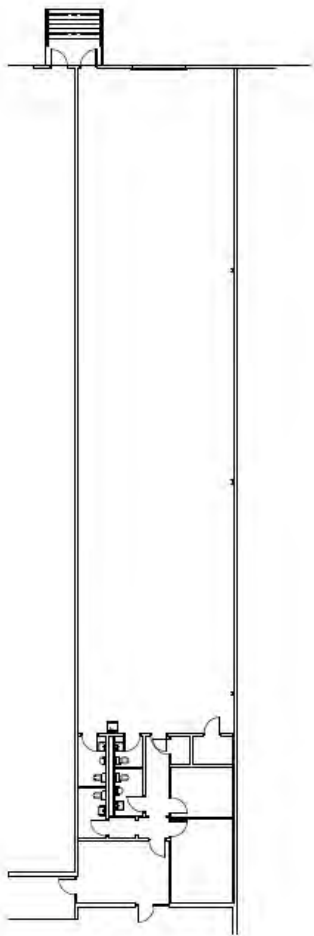

1 Overall Suite
SC-1 Scale: N.T.S.

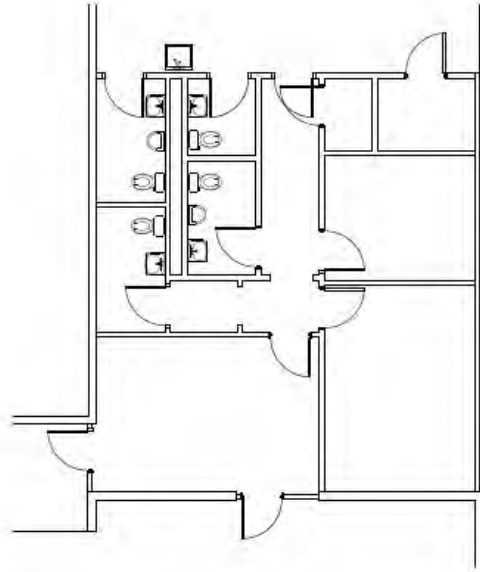

2 Office Layout
SC-1 Scale: 1/8" = 1'-0"



As Built • 47A1 Hugh Howell Rd • Office 938 SF • 4,800 SF Total



SPACE FEATURES

Suite D:

Available SF 4,800 SF

Office SF ± 1,938 SF

Loading 1 Dock High Door

Clear Height 18'

Sprinklered Yes

Parking 1.05/1,000 SF



CONTACT INFORMATION

Wilson Hull & Neal Real Estate

1600 Northside Dr | Suite 100
Atlanta, GA 30318

Joseph Rogers

jrogers@whnre.com
(404) 550-0817

Jamie Hargather

jhargather@whnre.com
(404) 944-4456

Conner Dickinson

cdickinson@whnre.com
(770) 542-7917

This document is for informational purposes only and does not constitute an offer or acceptance of a lease. Any lease agreement must be in writing and signed by the landlord. No representations or warranties are made except as expressly stated in a signed lease. Information is provided "as is" and may be subject to errors or change without notice.



LEASED BY

