



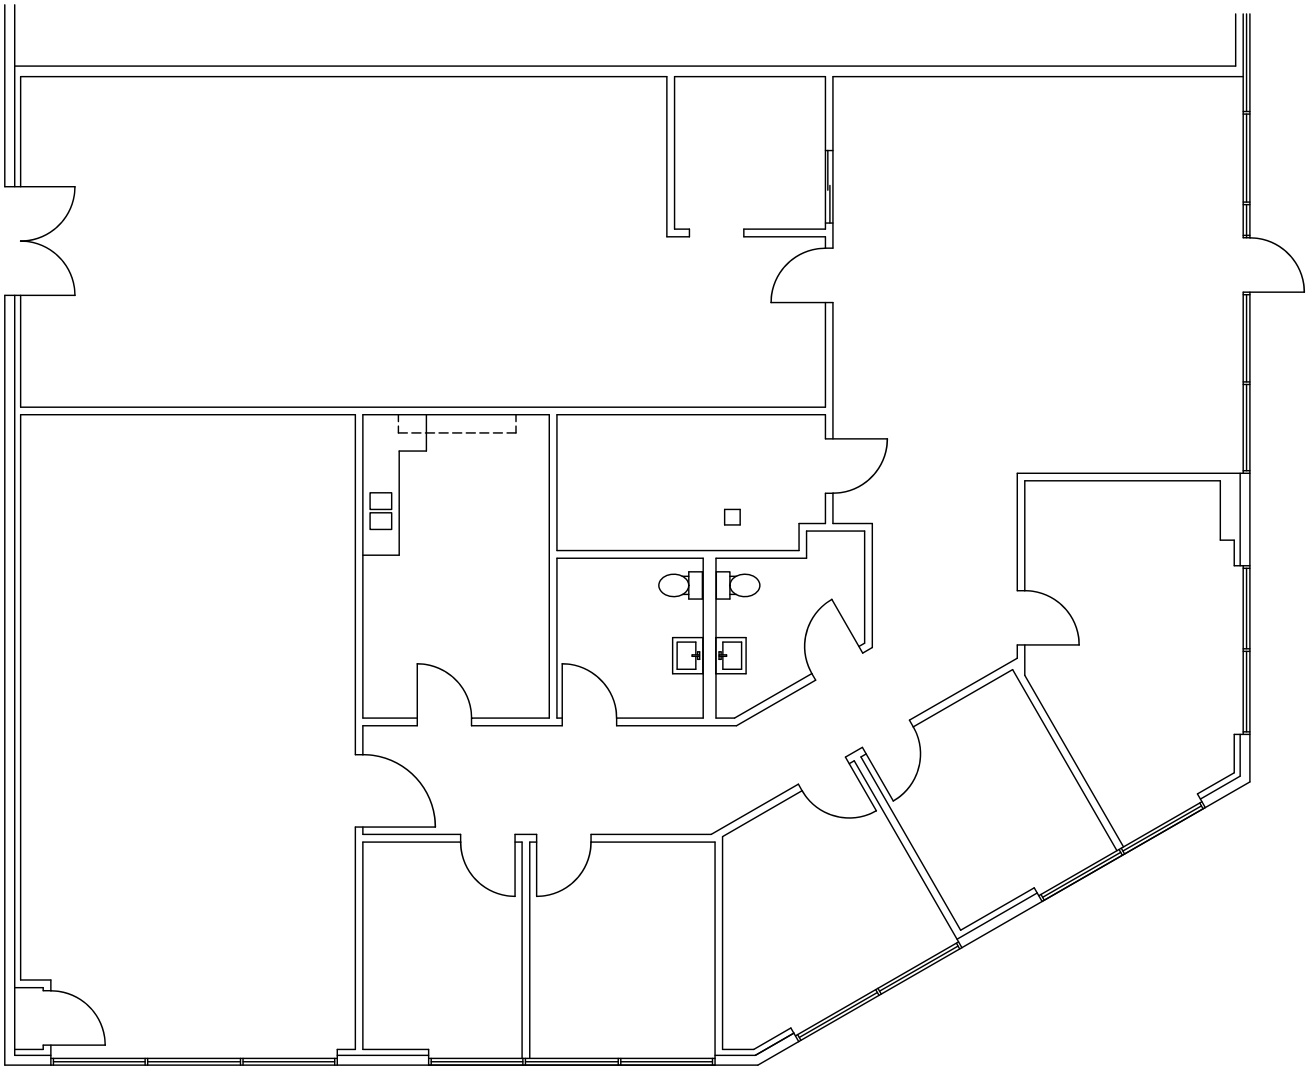

AS BUILT FLOOR PLAN

1/8" = 1'-0"

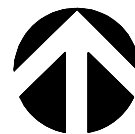

5733 RICKENBACKER ROAD
COMMERCE, CALIFORNIA