


2526 Manana Business Center As Built Marketing Package

Suite 103
Dallas, TX 75220

Sheet **A3**
Of 13 Sheet(s)

Scale: Not to Scale
Sheet Size: 11" x 8.5"
Not For Construction

© 2025 HosScans, LLC.
All right reserved.
These drawings and any associated documents are protected under U.S. copyright law. No part of this work may be produced, distributed, or used in any form, by any method, for any purpose, without the prior written consent of HosScans, LLC. Unauthorized use is subject to legal action.

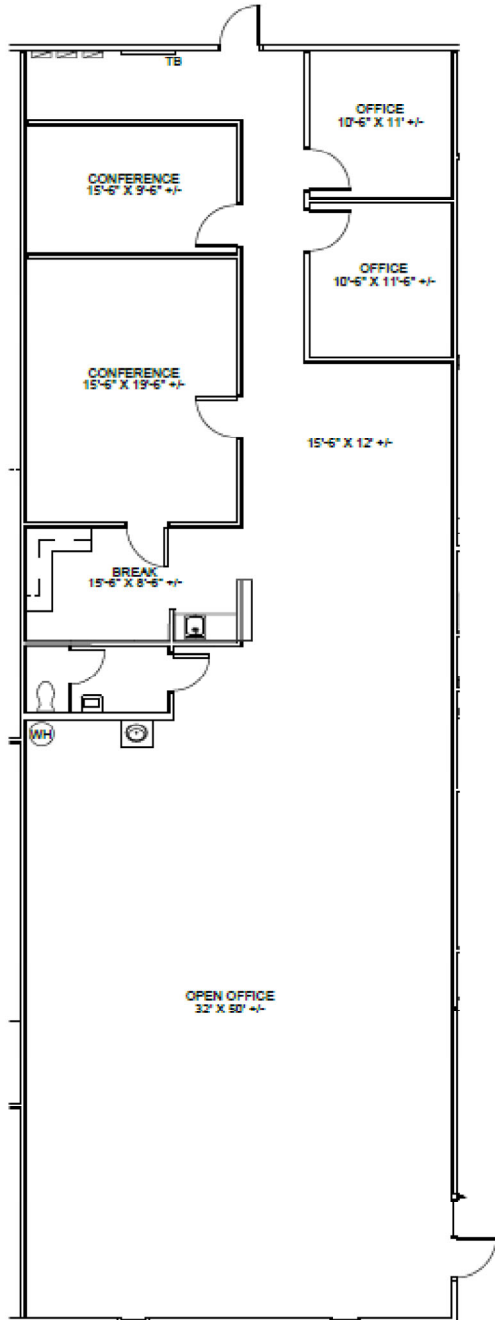

As Built Floor Plan for Marketing

