



MAGEE Construction L.S. 42  
 7/18/89  
 1188'

Plat # 42  
 of 118, 420  
 1188'

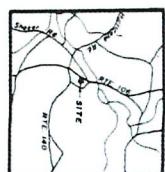

**NOTES:**

Proceeds, Treasurer, C.O.M. & SH&L 744  
 Owner of Record: MAGEE CONSTRUCTION CO.  
 Address: 440 0110  
 Property Surveyed: 1/1/2000  
 Surveyed by: MAGEE CONSTRUCTION CO.  
 Soil: M.C. - Middle Co. Soil Survey Sheet 44  
 Plan Reference: MAGEE CONSTRUCTION CO. JUNE  
 1988  
 Plan of Land for MAGEE CONSTRUCTION  
 Surveyed by: MAGEE CONSTRUCTION  
 Surveyed on: 06/19/88

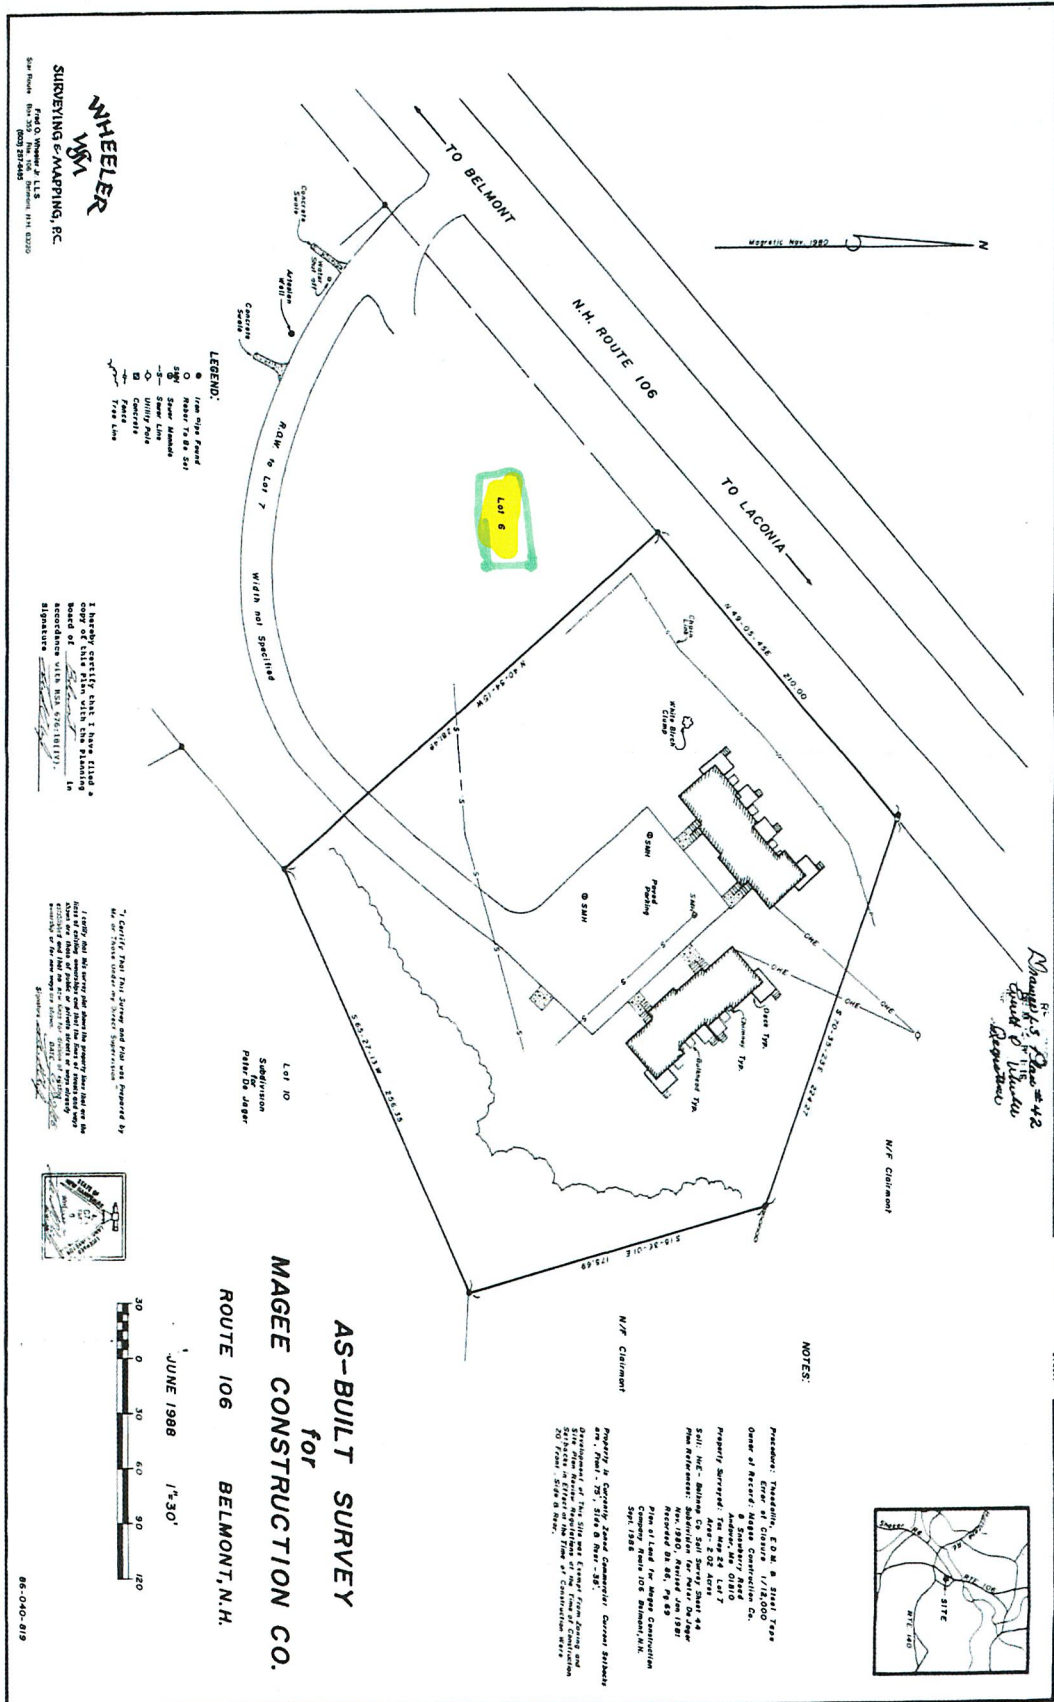


**AS-BUILT SURVEY**  
 for  
**MAGEE CONSTRUCTION CO.**  
 ROUTE 106 BELMONT, N.H.

**WHEELER**  
**W&M**  
**SURVEYING & MAPPING, P.C.**  
 2100 Thompson's L.L.S.  
 2100 Thompson's L.L.S.  
 2100 Thompson's L.L.S.


- LEGEND:**
- Iron Pipe Found
  - Nail 7/8" dia
  - ⊕ Stone Marker
  - Stone Line
  - ▭ Concrete
  - Pipe Line

I HEREBY CERTIFY THAT I HAVE MADE A REVISION TO THIS PLAN AND THE RECORDING RECORDS WITH MEASUREMENTS AND SIGNATURES

I CERTIFY THAT THIS SURVEY AND PLAN WAS PREPARED BY ME OR UNDER MY CLOSE SUPERVISION

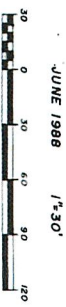

86-040-819

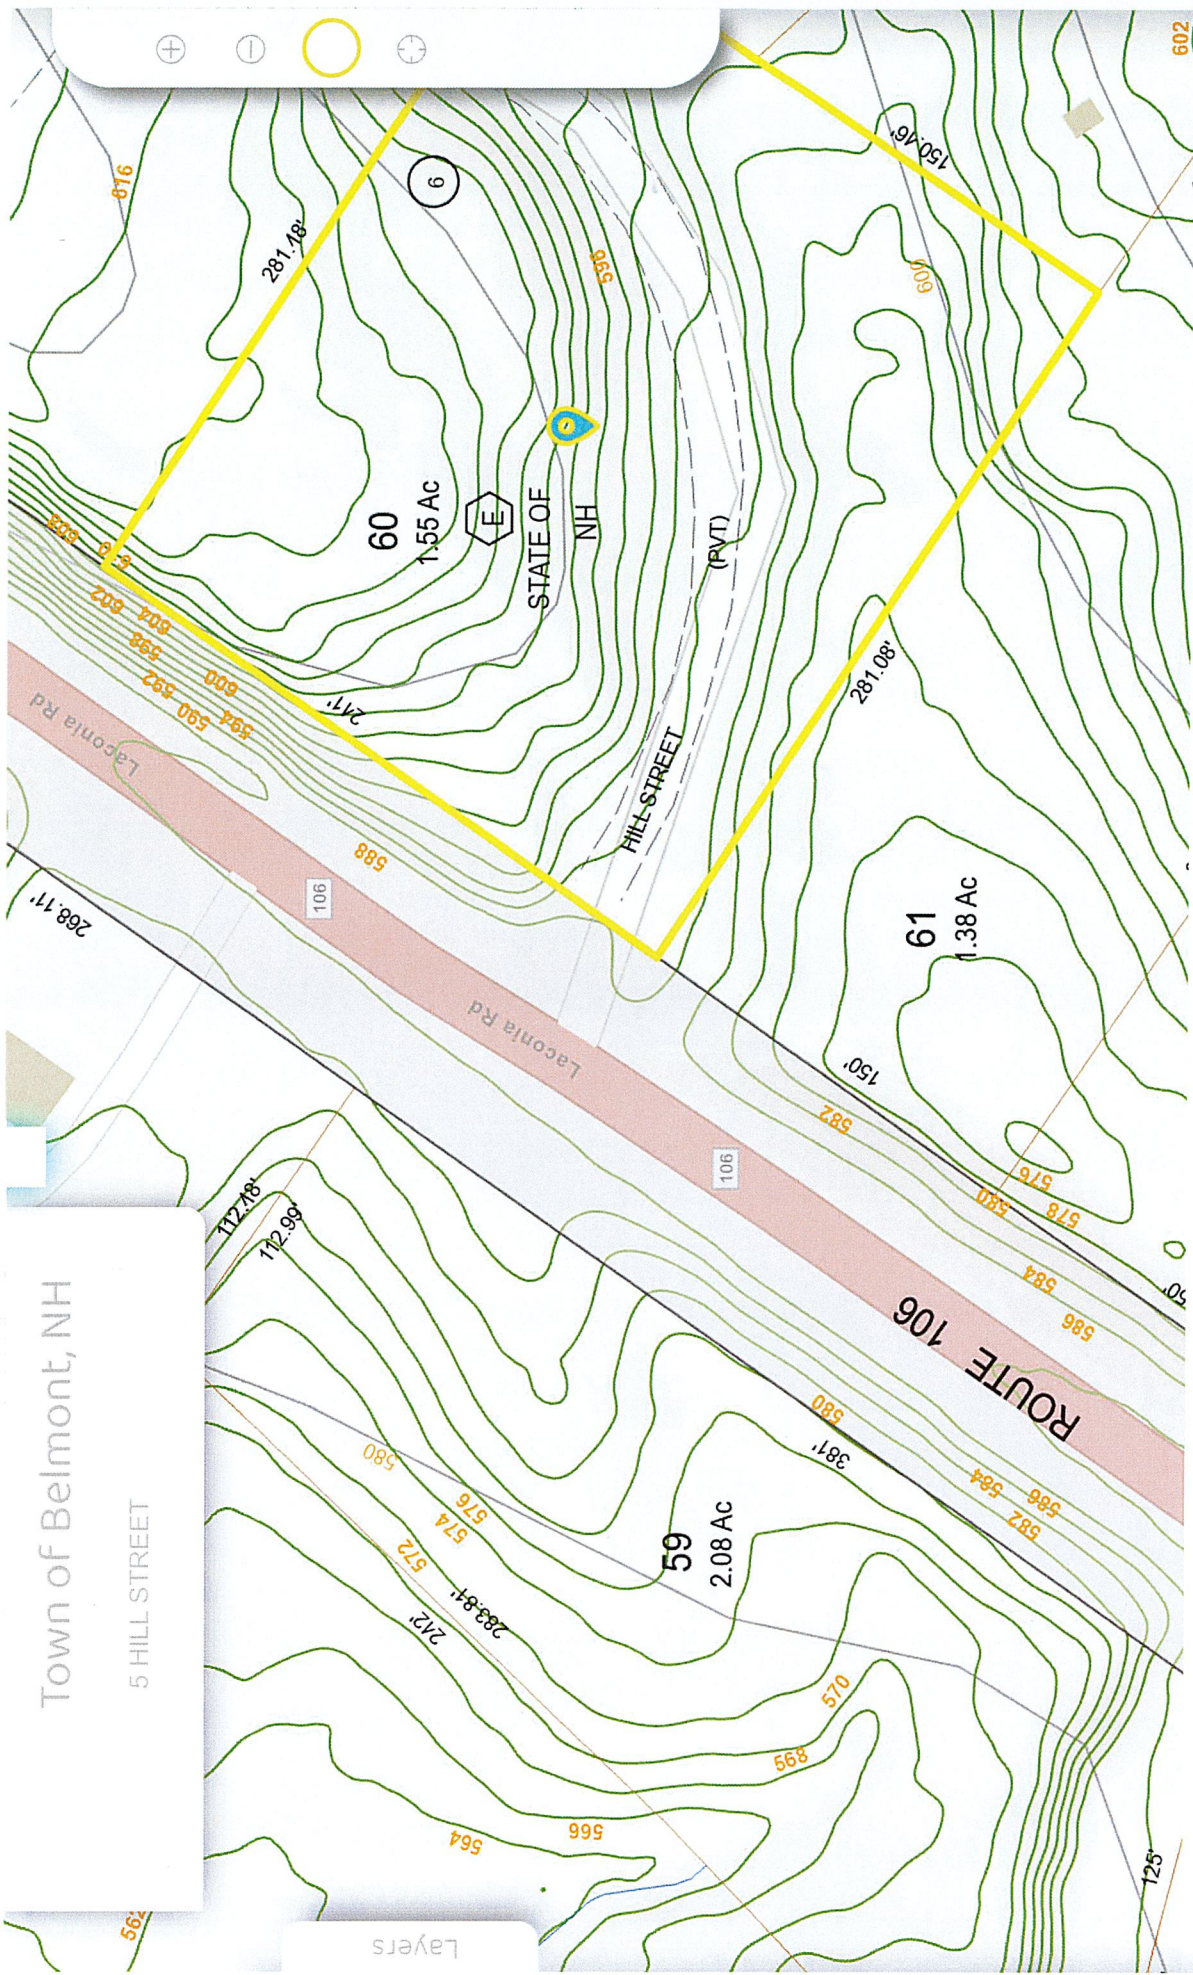

Town of Belmont, NH

5 HILL STREET

Layers

0 100 ft

x:-71.471916, y:43.447023