

2526 Manana Business Center As Built Marketing Package

Suite 102
Dallas, TX 75220

Sheet **A2**
Of 13 Sheet(s)

Scale: Not to Scale
Sheet Size: 11" x 8.5"
Not For Construction


© 2025 HosScans, LLC.
All right reserved.
These drawings and any associated documents are protected under U.S. copyright law. No part of this work may be produced, distributed, or used in any form, by any method, for any purpose, without the prior written consent of HosScans, LLC. Unauthorized use is subject to legal action.

Usable Square Foot Analysis

	SQFT	BUILDING PERCENTAGE
OFFICE AREA:	2,140	90%
WAREHOUSE AREA:	231	10%
TOTAL AREA:	2,371	

Building Information

Deck Height:	N/A
Ceiling Height:	9'-0"
Sprinklered:	No
Mechanical Area:	N/A

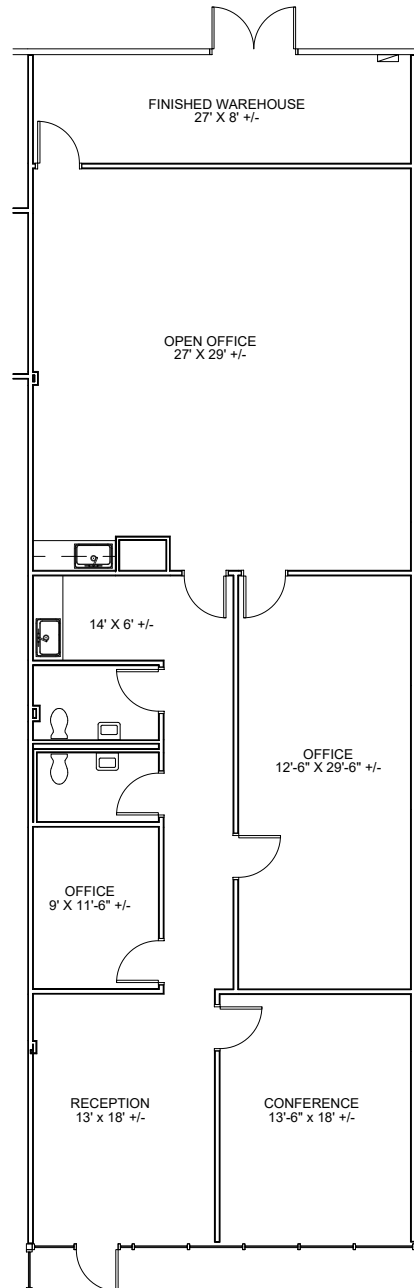

As Built Floor Plan for Marketing

