

GRANITE
VALLEY
MEDICAL
OFFICE


Floor 1

Suite 117

AS-BUILT

969 SF

AVAILABLE

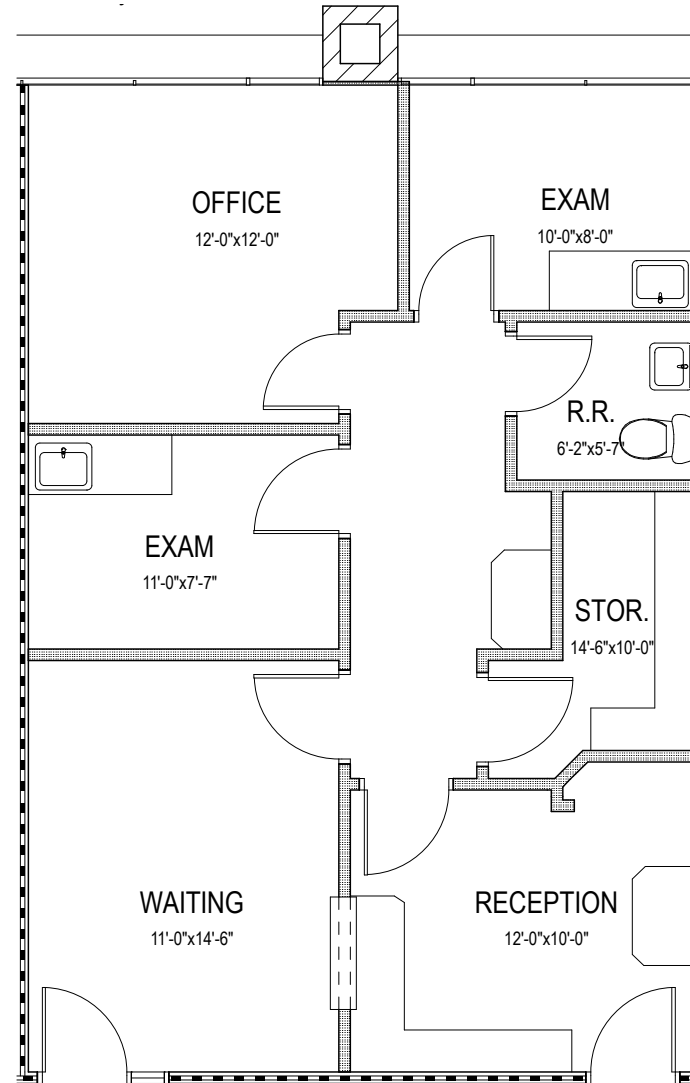

RACHAEL THOMPSON
Senior Vice President
602.513.5122
rachael.thompson@kidder.com

PERRY GABUZZI, CCIM
Senior Vice President
602.513.5116
perry.gabuzzi@kidder.com